

WATER SERVICE RECORD

Name

Service No.

#5176

Address

*House # 9*  
 Webster Road (lot 26) #  
*now lot 55*

#5177

Location

9 Webster Road


~~Repair - Renewal~~ - New Service SERVICE TO CURB

Date	Material	Amount	Total	Date	Amount
					<u>NON CHARGE</u>
				10/10/52	Labor 6 28
					27' 3/4" Copper tubing @ .34 9 18
					1 - 3/4" C. corp-cock 4 33
					1 - 3/4" C x 3/4" C. curb-cock 4 67
					1 box add red 3 90
					1 hr. trucking 75
					29 11

DATE \_\_\_\_\_

**TOWN OF LEXINGTON — BOARD OF PUBLIC WORKS**  
**WATER DIVISION**

Sketch of Service Here

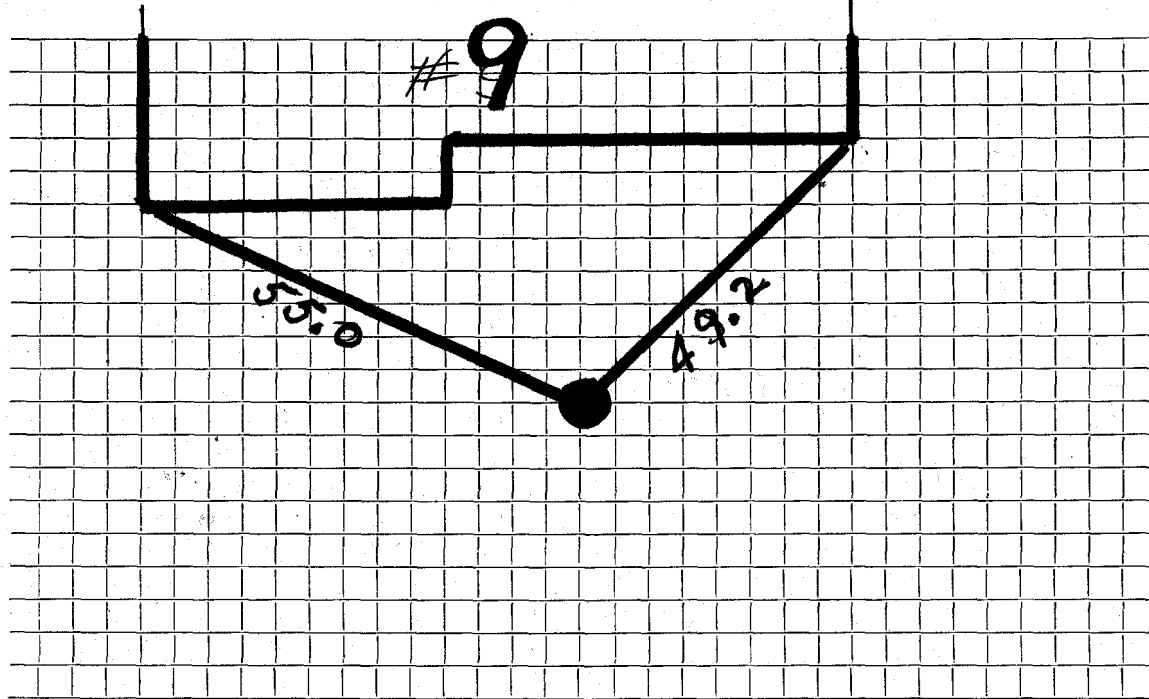

Connection made in ..... Street.                      Work completed .....

Remarks: .....  
.....  
.....