

WATER SERVICE RECORD

5178

Name John Cahill

Service No. 354

Address 10 Welch Road

Location

~~XXXXXX~~ New Service Conn. 12-19-55


Date	Material	Amount	Total	Date	Amount
11/16/55	Labor	1 85		11-16-55	Deposited 10 00
	10% overhead	19	2 04	12-19-55	Refunded 3 21
	1 - 3/4" x 1/2 I.W.H. stop & waste		4 00		NON CHARGE 6 79
	1 hr. trucking		75	11/16/55	Labor 1 85
			6 79		18' - 3/4" copper tubing @ .56 10 08
					1 - 3/4" C. corp-cock 4 33
					1 - 3/4" C. curb-cock 4 67
					1 box and rod 3 90
					1 - 1/2 straight tail pc. 50
					1 - 1/2 offset tail pc. 50
					25 83
	COPPER SUPPLIED BY OWNER:				

DATE _____

TOWN OF LEXINGTON — BOARD OF PUBLIC WORKS

WATER DIVISION

Sketch of Service Here

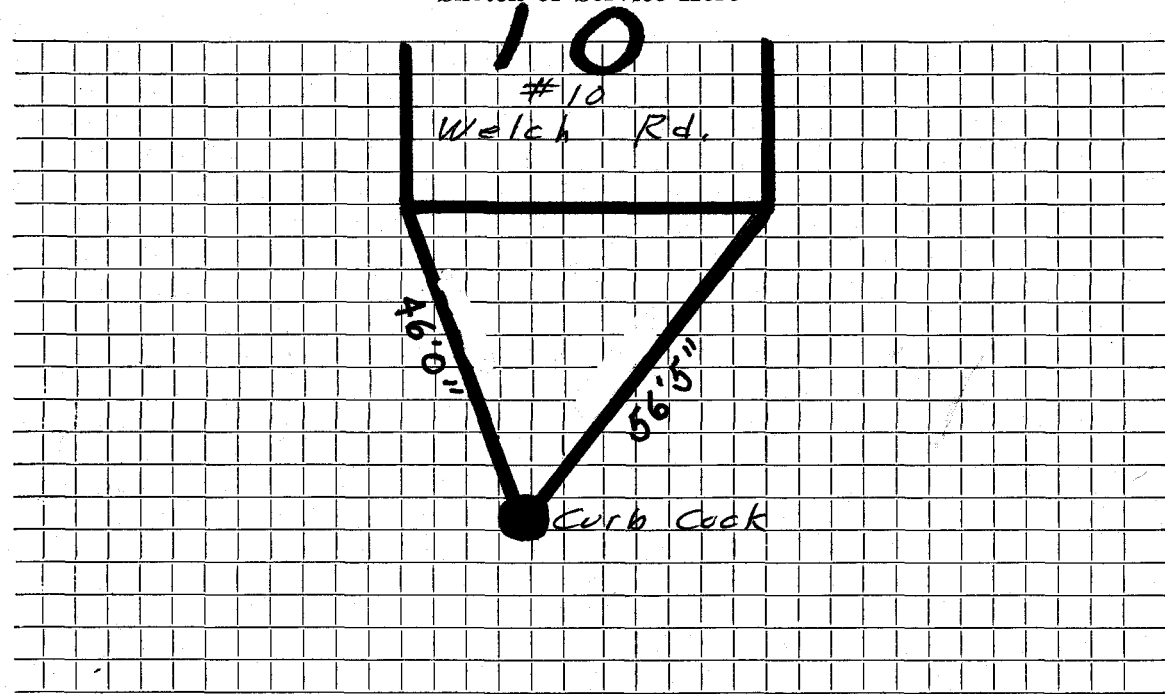

Connection made in Street. Work completed

Remarks:
.....
.....