

WATER SERVICE RECORD

2710

Service No.

354

Name John Cahill

Address 12 Welch Road

Location

~~Repair~~ ~~Renewal~~ — New Service

Comm. 12-19-55


Date	Material	Amount	Total	Date	Amount
11/16/55	Labor	1 85		11-16-55	Deposited 10 00
	10% Overhead	19	2 04	12-19-55	Refunded 3 21
	1 - 3/4 x 1/2 I.W.H. stop & waste		4 00		6 79
	1 hr. trucking		75		<u>NON-CHARGE</u>
			6 79	Labor	1 85
				12' - 3/4" copper tubing @.56	6 72
				1 - 3/4" C. corp. cock	4 33
				1 - 3/4" C. Curb cock	4 67
				1 Box & rod	3 90
				1 - 1/2" straight tail piece	50
				1 - 1/2" offset tail piece	50
					<u>22 47</u>
	Copper supplied by owner				

DATE _____

TOWN OF LEXINGTON — BOARD OF PUBLIC WORKS

WATER DIVISION

Sketch of Service Here

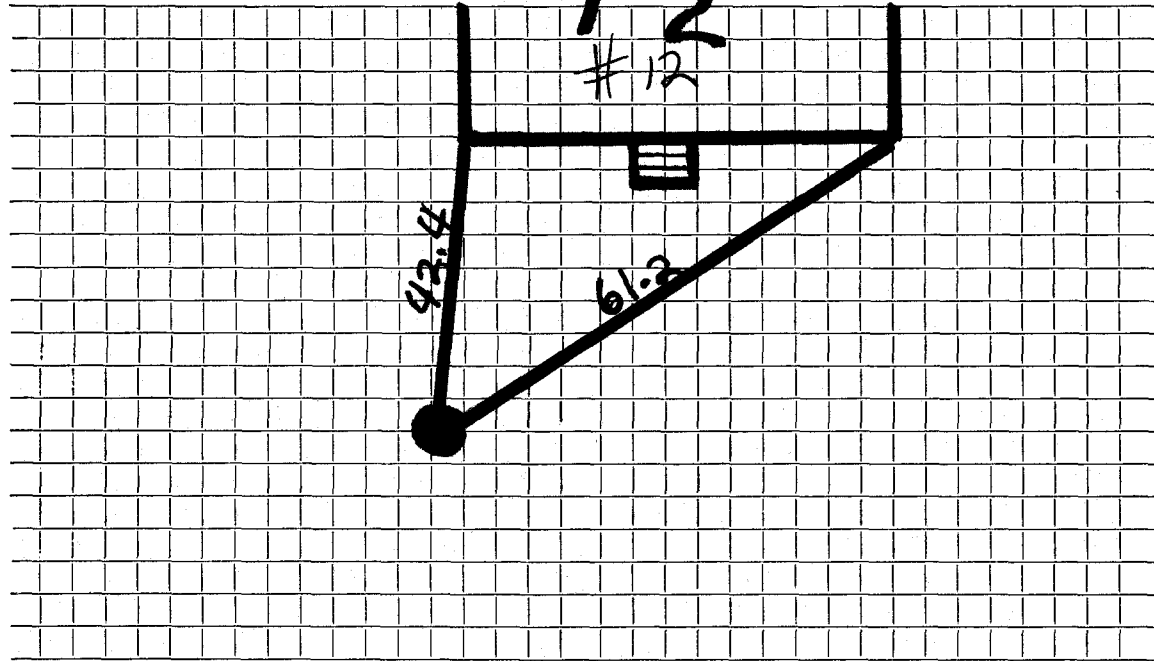

Connection made in Street. Work completed

Remarks:
.....
.....