

WATER SERVICE RECORD

Name John F. Cahill

Service No. 36

Address 15 Welch Road

Location


~~Repair - Renewal~~ - New Service

Date	Material	Amount	Total	Date	Amount
4/3/56	Labor	1 95		3-16-56	Deposit \$ 10 00
	10% overhead	20	2 15	8-6-56	Refund 2 14
	1 - 3/4" Cx 1/2" I.W.H. Stop & Waste		4 96		NON CHARGE \$ 7 86
	1 hr. trucking		75	4/3/56	Labor 1 90
			7 86	15'	3/4" Copper tubing @ .4850 7 28
				1 -	3/4" C. Corp Cock 4 34
	Owner supplied copper			1 -	3/4" C. Curb Cock 5 94
				1	Box & Rod 4 62
				1	1/2" Straight tailpiece 50
				1	1/2" Offset tailpiece 50
					<u>25 08</u>

DATE _____

TOWN OF LEXINGTON — BOARD OF PUBLIC WORKS
WATER DIVISION

Sketch of Service Here

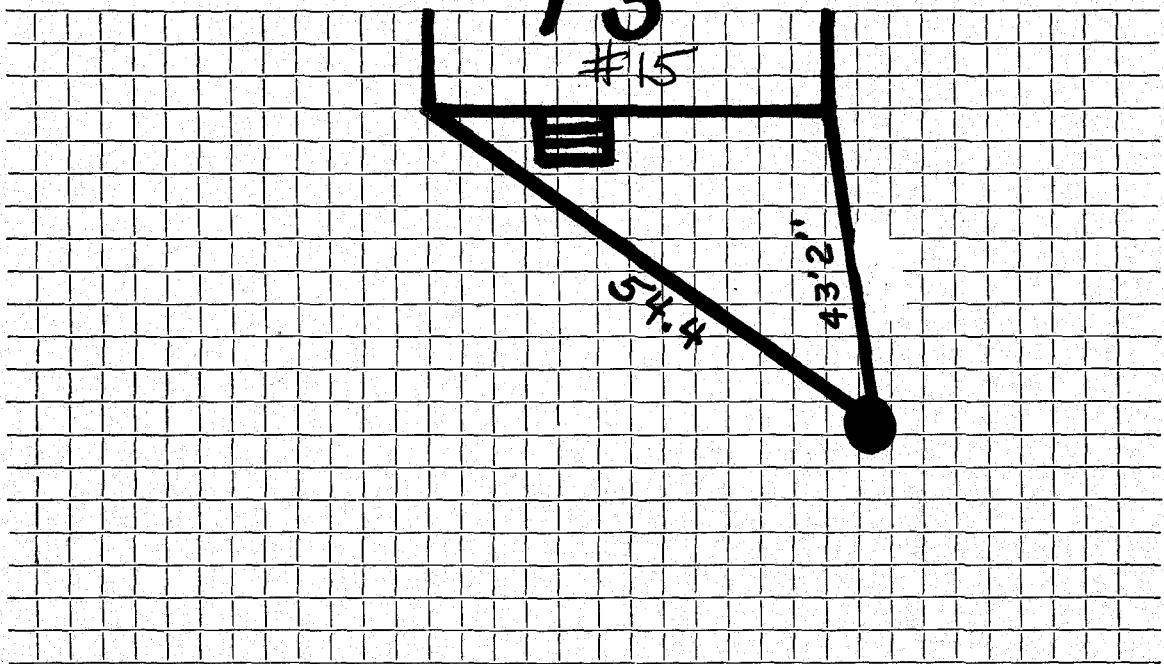

Connection made in Street. Work completed

Remarks:
.....
.....