

## WATER SERVICE RECORD

1246

Service No.

354

Name John Cahill

Address 16 Welch Road, Lexington, Mass.

Location

~~Repair - Renewal~~ - New Service*Com.*  
12-19-55

Copper supplied by owner


Date	Material	Amount	Total	Date	Amount
11/16/55	Labor	1 85		11-8-55 Deposited	10 00
	10% Overhead	19	2 04	12-19-55 Refunded	3 21
	1-3/4"C x 1/2" I.W.H. stop & waste		4 00	NON-CHARGE	6 79
	1 hr. trucking @ .75		75	11/16/55 Labor	1 85
			6 79	17'-3/4" Copper tubing @ .56	9 52
				1-3/4"C Corp Cock	4 33
				1-3/4"C Curb Cock	4 67
				1 Box & Rod	3 90
				1-1/2" straight tail piece	50
				1-1/2" offset tail Piece	50
					25 27
				NON-CHARGE -W.O.#2142	
				4/22/66 Labor	47.85
				10 % O.H.	4.79
				5' copper @ .70	3 50
				1 corp	7 42
				1 1/2 union	3 05
				1 1/2 shovel & truck	6 25
					72 86

DATE \_\_\_\_\_

TOWN OF LEXINGTON — BOARD OF PUBLIC WORKS

WATER DIVISION

Sketch of Service Here

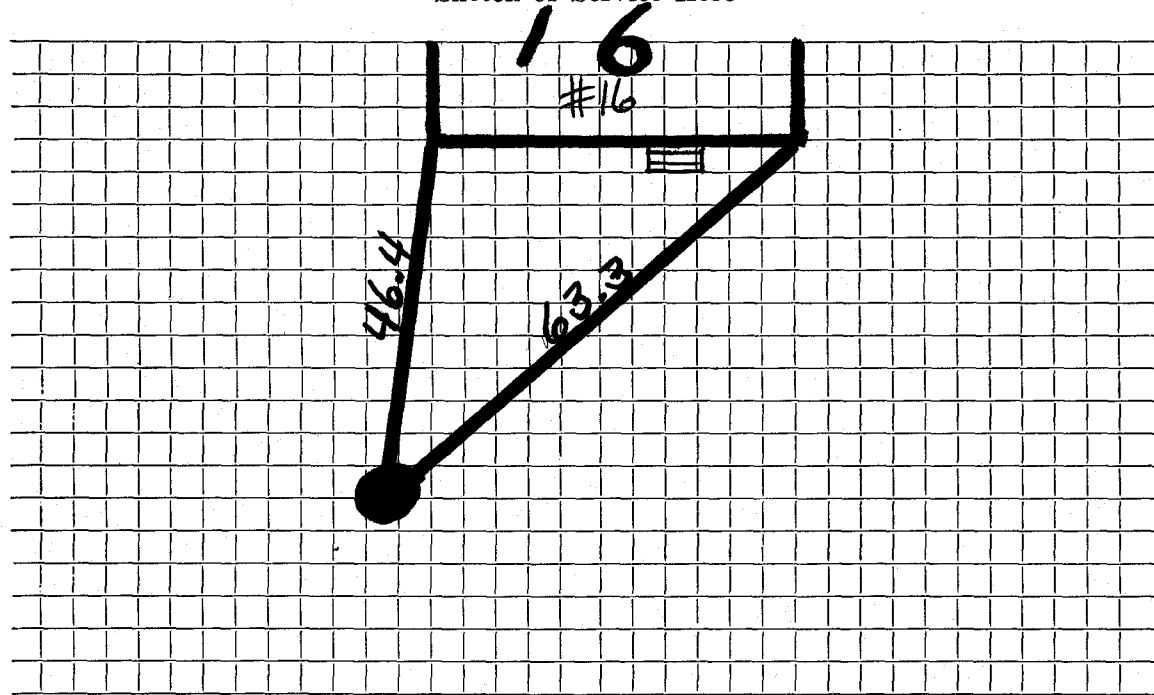

Connection made in ..... Street. Work completed .....

Remarks: .....

.....

.....