

WATER SERVICE RECORD

Name John F. Cahill

Service No. 37

Address 17 Welch Road

Location

~~Repair-Renewal~~—New Service


Date	Material	Amount	Total	Date	Amount
4/3/56	Labor	1 95		8-80-56 Deposit	\$ 10 00
	10% overhead	20	2 15	8-6-56-Refund	2 14
	1 - 3/4" Cx 1/2" I.W.H. Stop & Waste	4 96		NON CHARGE	\$ 7 86
	1 hr. trucking		75	4/3/56 Labor	1 90
			7 86	15' - 3/4" Copper tubing @ .4850	7 28
				1 - 3/4" C. Corp Cock	4 34
				1 - 3/4" C. Curb Cock	5 94
				1 Box & Rod	4 62
				1 - 1/2" straight	50
				1 - 1/2" offset tailpiece	50
					25 08

DATE _____

TOWN OF LEXINGTON — BOARD OF PUBLIC WORKS

WATER DIVISION

Sketch of Service Here

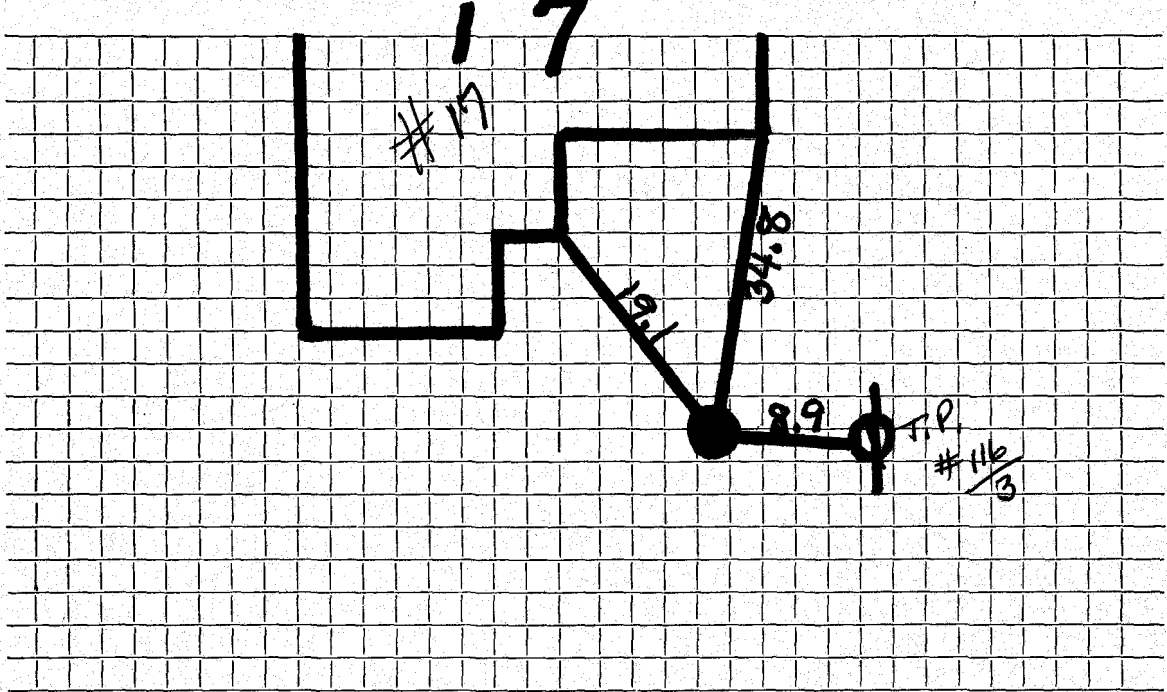

Connection made in Street. Work completed

Remarks:
.....
.....