

WATER SERVICE RECORD

251

Name John F. Cahill

Service No. 34

Address 2 Welch Road

Location


Repair Amount - New Service

Date	Material	Amount	Total	Date	Amount
4/3/56	Labor	1 95		3-16-56	Deposit \$ 10 00
	10% overhead	20	2 15	8-6-56	Refund 2 15
	1 - 3/4" Cx 1/2" I.W.H. Stop & Waste	4 96			NON CHARGE 7 86
	1 hr. trucking		75	4/3/56	Labor 1 95
			7 86		
				30' - 3/4" Copper tubing @ .4850-	14 55
				1 - 3/4" C. Corp Cock	4 34
				1 - 3/4" C. Curb Cock	5 94
	Owner supplied copper			1 - Box & Rod	4 62
				1 - 1/2" Straight tailpiece	50
				1 - 1/2" Offset tailpiece	50
					<u>32 40</u>

DATE _____

TOWN OF LEXINGTON — BOARD OF PUBLIC WORKS
WATER DIVISION

Sketch of Service Here

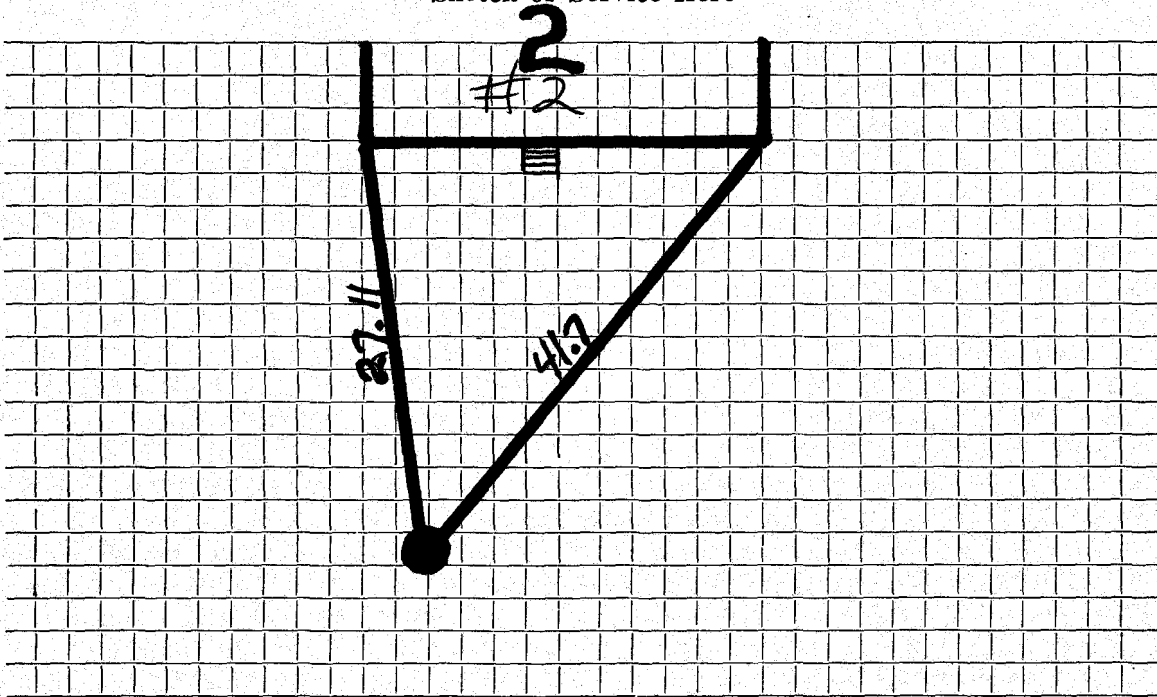

Connection made in Street. Work completed

Remarks:
.....
.....