

WATER SERVICE RECORD

Name John Cahill

Service No. 354

Address 20 Welch Road

Location

~~Repair-Renewal~~ - New Service *Conn. 12-19-55*


Date	Material	Amount	Total	Date	Amount
11/16/55	Labor	1 85		11-8-55	Deposited 10 00
	10% overhead	19	2 04	12-19-55	Refunded 3 21
	1 - 3/4 C x 1/2 I.W.H. stop & waste		4 00		6 79
	1 hr. trucking		75		<u>NON-CHARGE</u>
			6 79	Labor	1 85
				20' - 3/4" copper tubing @ .56	11 20
				1 - 3/4 C. Corp Cock	4 33
				1 - 3/4 C. Curb Cock	4 67
				1 box & rod	3 90
				1 - 1/2" straight tail piece	50
				1 - 1/2" offset tail piece	50
					<u>26 95</u>
	Copper supplied by owner				

DATE \_\_\_\_\_

TOWN OF LEXINGTON — BOARD OF PUBLIC WORKS

**WATER DIVISION**

Sketch of Service Here

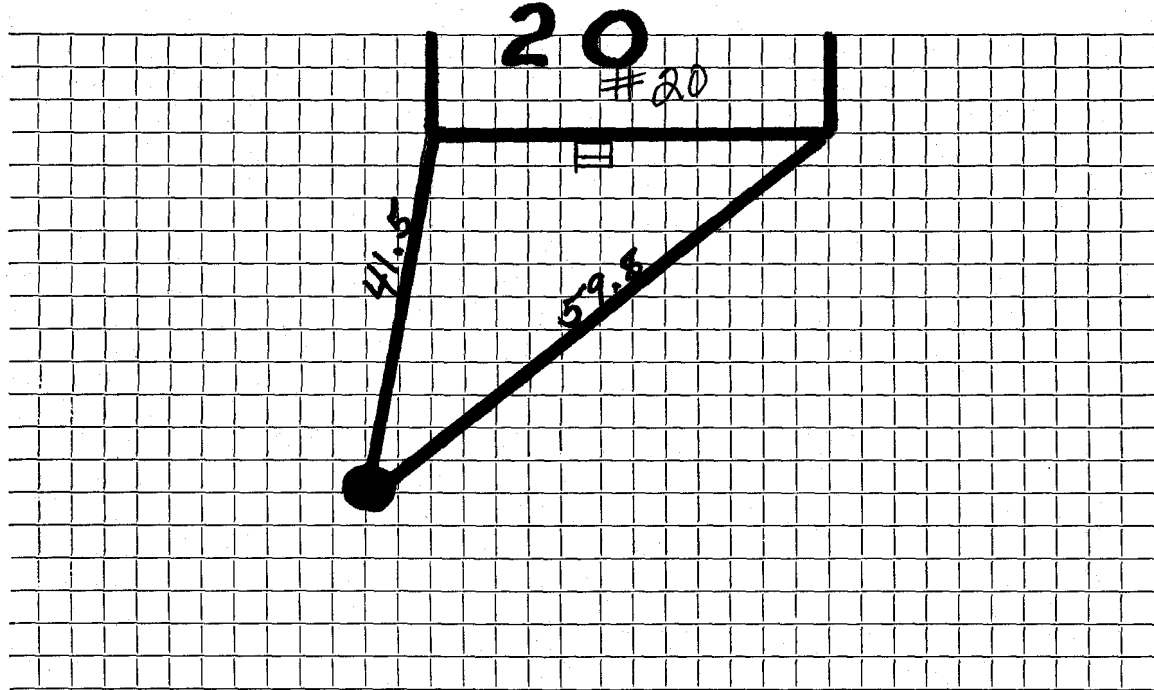

Connection made in ..... Street.      Work completed .....

Remarks: .....  
.....  
.....