

## WATER SERVICE RECORD

Name John F. Cahill

Service No. 38

Address 21 Welch Road

# 3176

Location

~~Repair~~ ~~Renewal~~ New Service


Comm. 10-29-56

| Date    | Material                          | Amount | Total | Date     | Amount                    |       |
|---------|-----------------------------------|--------|-------|----------|---------------------------|-------|
| 4/16/56 | Labor                             | 1.95   |       | 3-16-56  | Deposit                   | 10.00 |
|         | 10% overhead                      | .20    | 2.15  | 10-29-56 | Refund                    | 2.14  |
|         | Owners Copper                     |        |       |          |                           | 7.86  |
|         | 1 3/4 C x 1/2 I.W.H. Stop & Waste |        | 4.96  |          | NON CHARGE                |       |
|         | 1 Hr. trucking @ .75              |        | .75   | 4/16/56  | 1 1/2 Straight tail piece | .50   |
|         |                                   |        | 7.86  |          | 1 1/2 Offset tail piece   | .50   |
|         |                                   |        |       |          |                           | 1.00  |

TOWN OF LEXINGTON — BOARD OF PUBLIC WORKS

WATER DIVISION

Sketch of Service Here

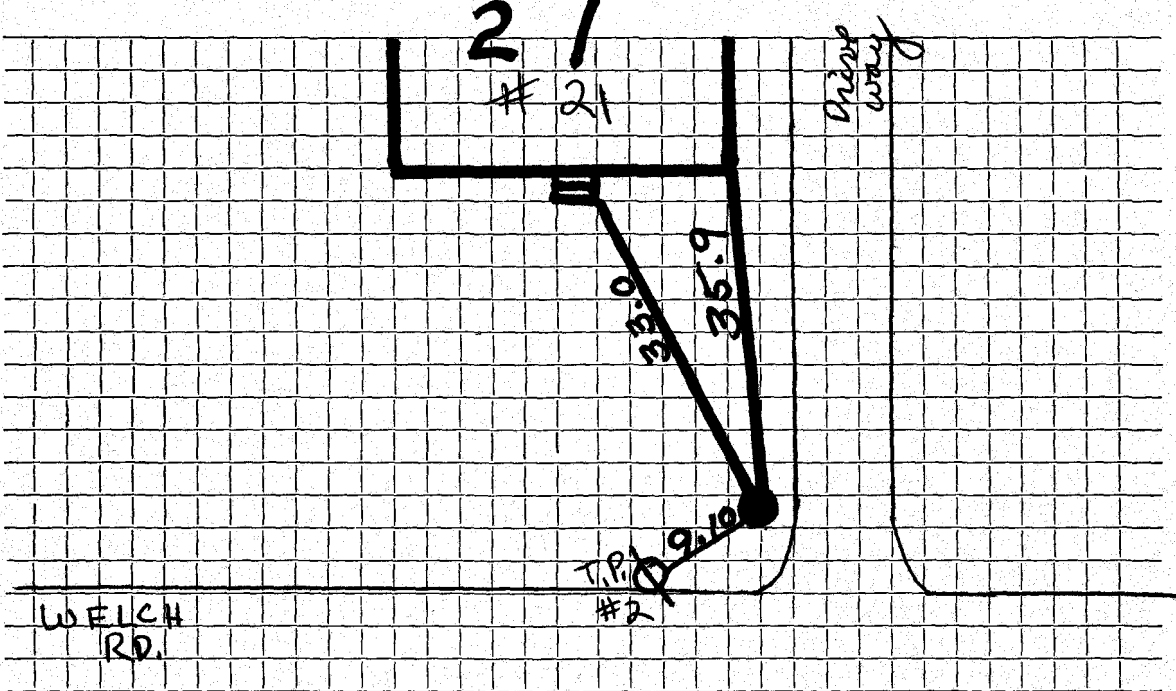

Connection made in ..... Street. Work completed .....

Remarks: .....  
.....  
.....