

WATER SERVICE RECORD

3620
5428
242

Name John Cahill

Service No.

Address 4 Welch Road
~~4 Hill Avenue~~

Location 4 Welch Road

~~REPAIR~~ ~~REPAIR~~ New Service

COM.10-10-55


Date	Material	Amount	Total	Date	Amount
7/27/55	Labor	4 15		7-26-55	Deposited 10 00
	10% overhead	42	4 57	10-10-55	Refunded 68
	1 - 3/4" I.W.H. stop & waste		4 00		<u>NON CHARGE</u> 9 32
	1 hr. trucking		75	7/27/55	Labor 4 15
			9 32	22' - 3/4" copper tubing @ .384	8 45
owner supplied	copper tubing			1 - 3/4" corp-cock	4 33
				1 - 3/4" C. curb-cock	4 67
				1 box and rod	3 90
				1 - 3/8" offset tail pc.	50
				1 - 3/8" straight tail pc.	50
					<u>26 50</u>

DATE _____

TOWN OF LEXINGTON — BOARD OF PUBLIC WORKS

WATER DIVISION

Sketch of Service Here

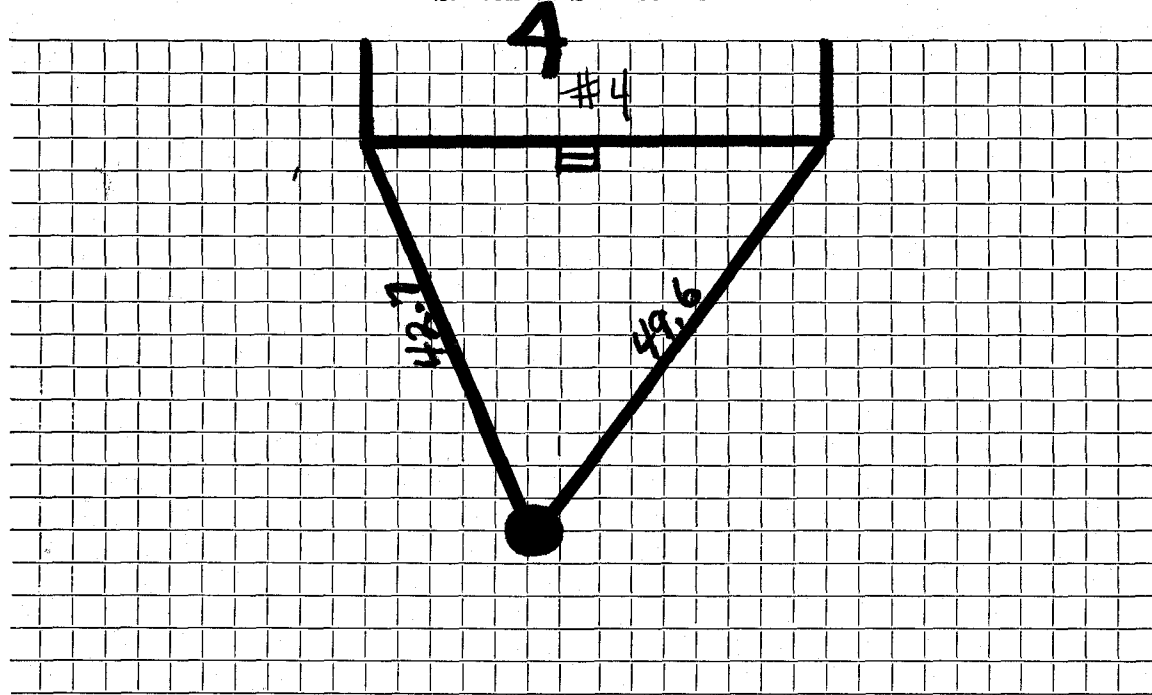

Connection made in Street. Work completed

Remarks:
.....
.....