

WATER SERVICE RECORD

Name John Cahill

Service No. 243

Address 6 Welch Road
6 Hill Avenue

438

Location 6 Welch Road

~~RENEWAL~~ - New Service

COM. 10-10-55


Date	Material	Amount	Total	Date	Amount
7/27/55	Labor	4 15		7-26-55 Deposited	10 00
	10% overhead	42	4 57	10-10-55 Refunded	68
	1 - 3/4" I.W.H. stop & waste		4 00	<u>NON CHARGE</u>	9 32
	1 hr. trucking		75	7/27/55 Labor	4 17
			9 32	22' - 3/4" copper tubing @ .384	8 45
	Trench dug by owner			1 - 3/4" C. corp-cock	4 33
	Pipe supplied by owner			1 - 3/4" C. curb-cock	4 67
				1 box and rod	3 90
				1 - 1/8" offset tail pc.	50
				1 - 1/2" straight tail pc.	50
					<u>26 52</u>

DATE _____

TOWN OF LEXINGTON — BOARD OF PUBLIC WORKS

WATER DIVISION

Sketch of Service Here

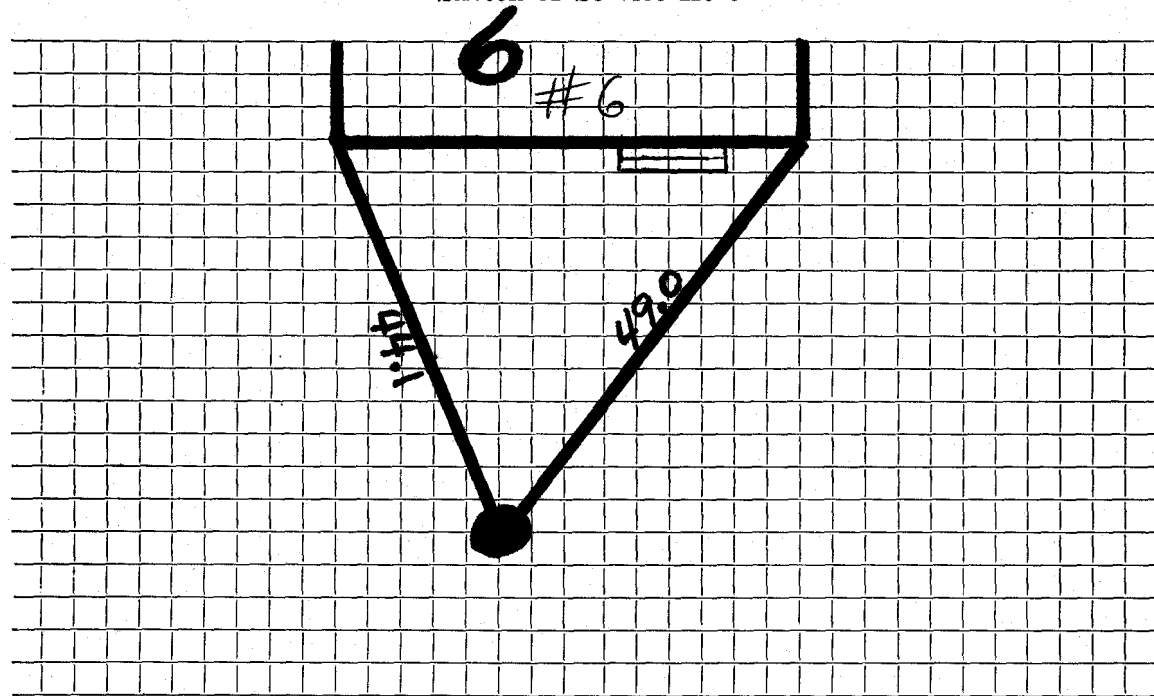

Connection made in Street. Work completed

Remarks:

.....

.....