

WATER SERVICE RECORD

#4988

Name John Cahill

Service No. 244

Address 800 Welch Road
 Hill Avenue

Location

~~XXXXXX~~ New Service

COM.10-10-55


Date	Material	Amount	Total	Date	Amount
7/27/55	Labor	4 15		7-26-55 Deposited	10 00
	10% overhead	42	4 57	11-10-55 Refunded	68
	1 - 3/4"C. x 1/8"I.W.H.stop& waste	4 00		<u>NON CHARGE</u>	9 32
	1 hr. trucking		75	7/27/55 Labor	4 15
			9 32	22' - 3/4" copper tubing@.384	8 45
	trench dug by owner			1 - 3/4"C. corp-cock	4 33
	pipe supplied by owner			1 - 3/4"C. curb-cock	4 67
				1 box and rod	3 90
				1 - 1/2 offset tail pc.	50
				1 - 1/2 straight tail pc.	50
					<u>26 50</u>

DATE _____

TOWN OF LEXINGTON — BOARD OF PUBLIC WORKS

WATER DIVISION

Sketch of Service Here

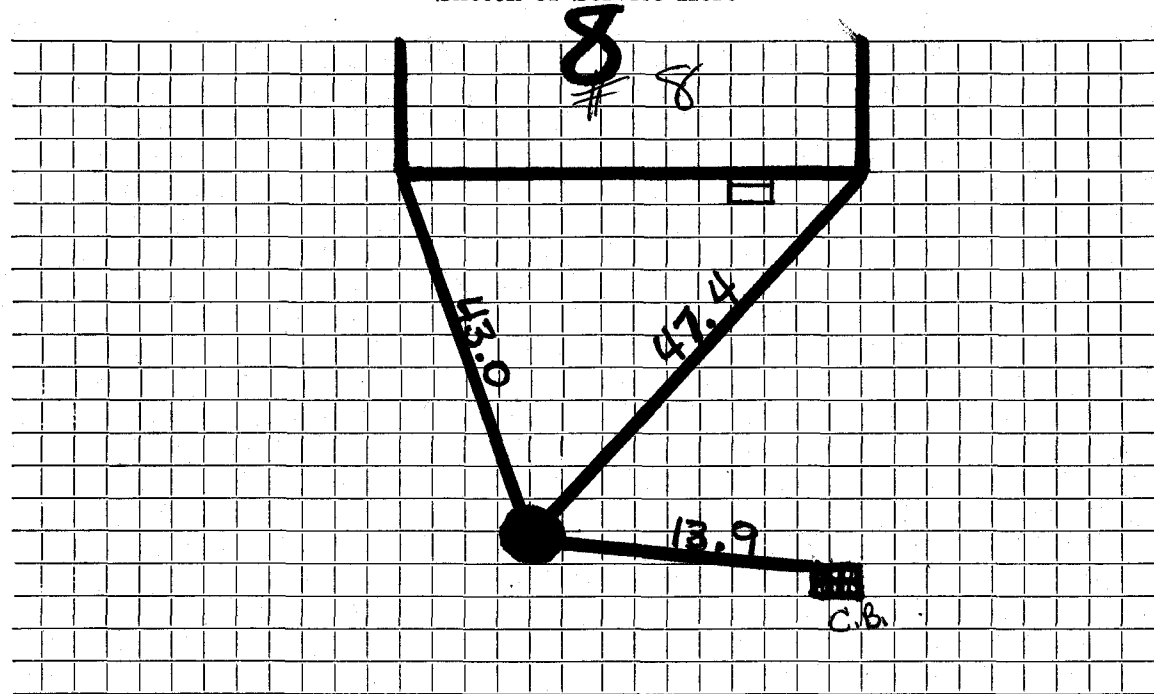

Connection made in Street. Work completed

Remarks:
.....
.....