

WATER SERVICE RECORD

Name John F. Cahill

Service No. 35

Address 9 Welch Road

12807

7454

Location

~~Repair Renewal~~—New Service


Date	Material	Amount	Total	Date	Amount
4/3/56	Labor	1 95		3-28-56 Deposit	\$ 10 00
	10% overhead	20	2 15	8-6-56 Refund	2 14
	1 - 3/4" Cx 1/2" I.W.H. Stop & Waste		4 96	NON CHARGE	\$ 7 86
	1 hr. trucking		75	4/3/56 Labor	1 95
			7 86	15' - 3/4" Copper tucing @ .4850	7 28
				1 - 3/4" C. Corp Cock	4 34
				1 - 3/4" C. Curb Cock	5 94
	Owner supplied copper			1 Box & Rod	4 62
				1 - 1/2" Straight tailpiece	50
				1 - 1/2" Offset tailpiece	50
					25 13

DATE _____

TOWN OF LEXINGTON — BOARD OF PUBLIC WORKS

WATER DIVISION

Sketch of Service Here

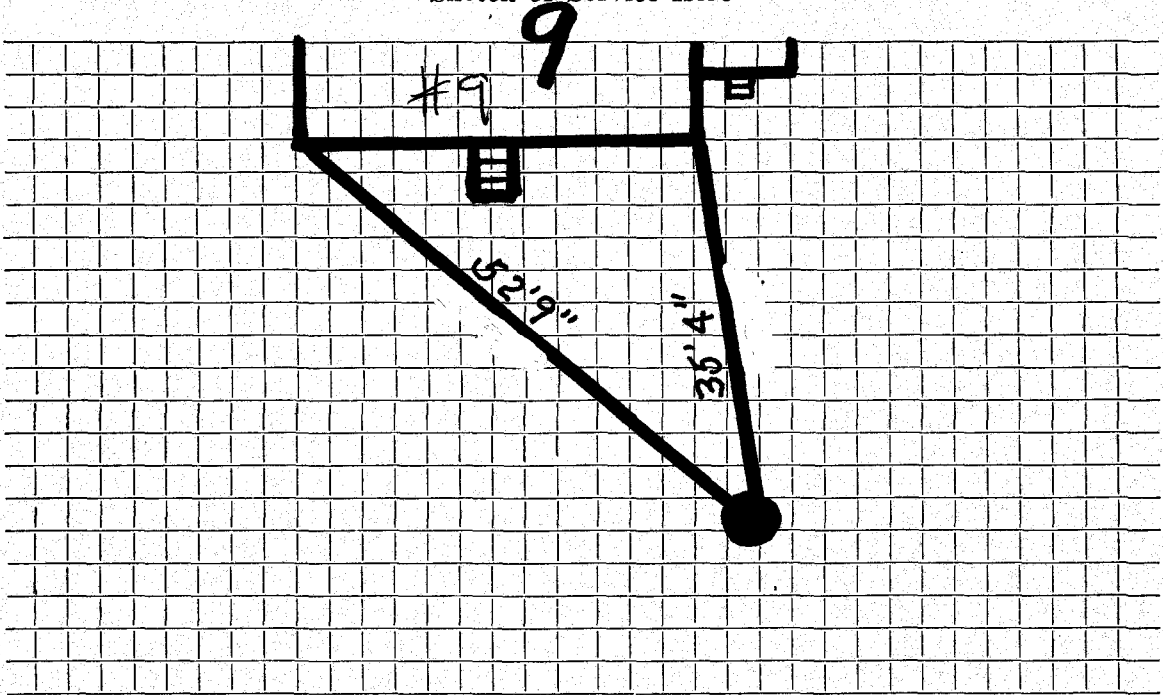

Connection made in Street. Work completed

Remarks:
.....
.....