

WATER SERVICE RECORD

Name LOUIS DI LUNA JR.

Service No. 25

Address 11 WELLINGTON LANE

Location

~~Repair~~ ~~Renewal~~ ~~New Service~~ W.P. 5662

DEC. 12 1977


Date	Material	Amount	Total	Date	Amount
8/19/77	Labor	195.31		8-15-77	Deposit 150.00
	10% O.H.	19.53	214.84	1-3-78	Paid 145.00
	16' 7" of 1" copper @ 1.08		17.38		295.00
	1 1" Corporation		16.69		
	1 1" CURB		20.54		
	1 Box 1/2 Rod		13.40		
	1 Hr. Trucking		3.00		
	1 1/2 Town Shave @ 6.50		9.75		
			<u>295.60</u>		
9/8/77	36' of 1" copper				

DATE _____

TOWN OF LEXINGTON — BOARD OF PUBLIC WORKS

WATER DIVISION

Sketch of Service Here

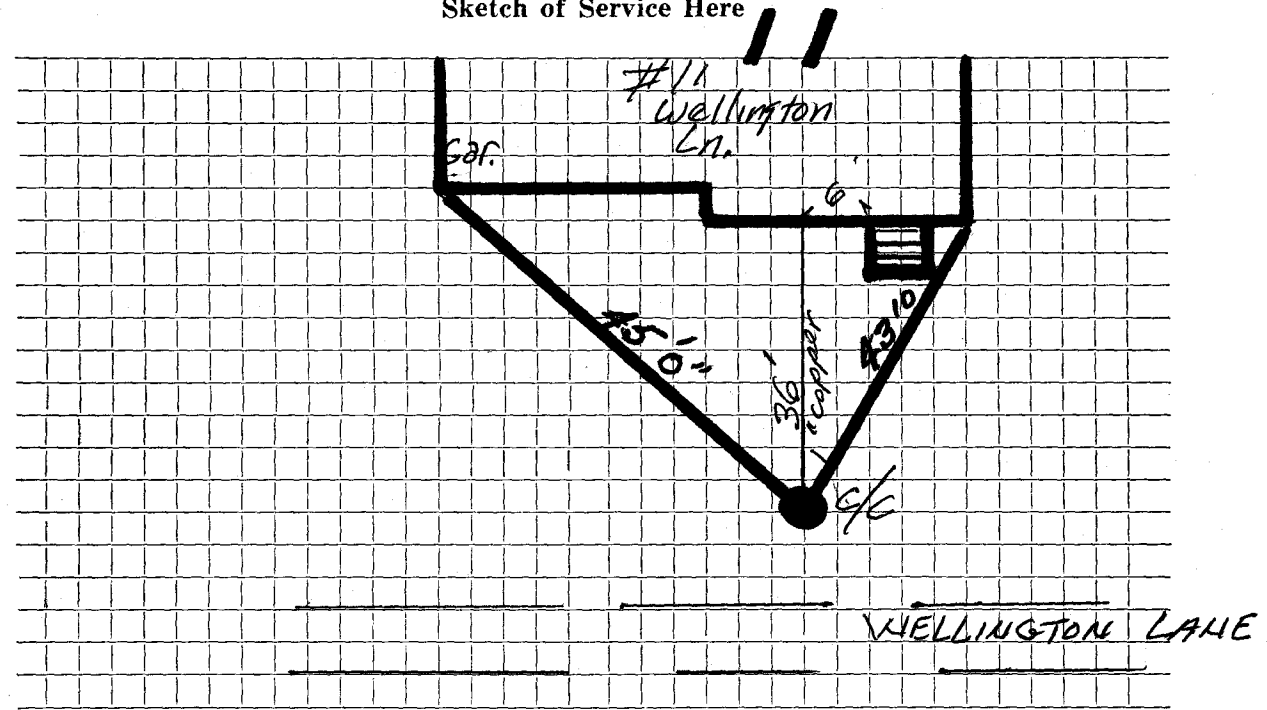

Connection made in Street. Work completed

Remarks:
.....
.....