

WATER SERVICE RECORD

Name Dave Zaloga

Service No. 47

Address 12 Wellington Lane.

Location

Repair—Renewal—New Service WO #4851

MAY 9 1977


Date	Material	Amount	Total	Date	Amount
9/10/76	labor	89. 56		9-10-76	300 00
	10%oh	8. 96	98. 52	5-9-77	124 35
30'	3/4" Copper @ .65		19. 50		175 65
1	3/4" Curb.		13. 70		
1	3/4" Corp.		10. 53		
1	box and rod		15. 40		
1	hr. trucking		3. 00		
2	hr. shovel @ 6.50		13. 00		
1/2	hr. loader @ 4.00		2. 00		
			175. 65		
10-19-76	48' 3/4" Copper				

DATE _____

TOWN OF LEXINGTON — BOARD OF PUBLIC WORKS

WATER DIVISION

Sketch of Service Here

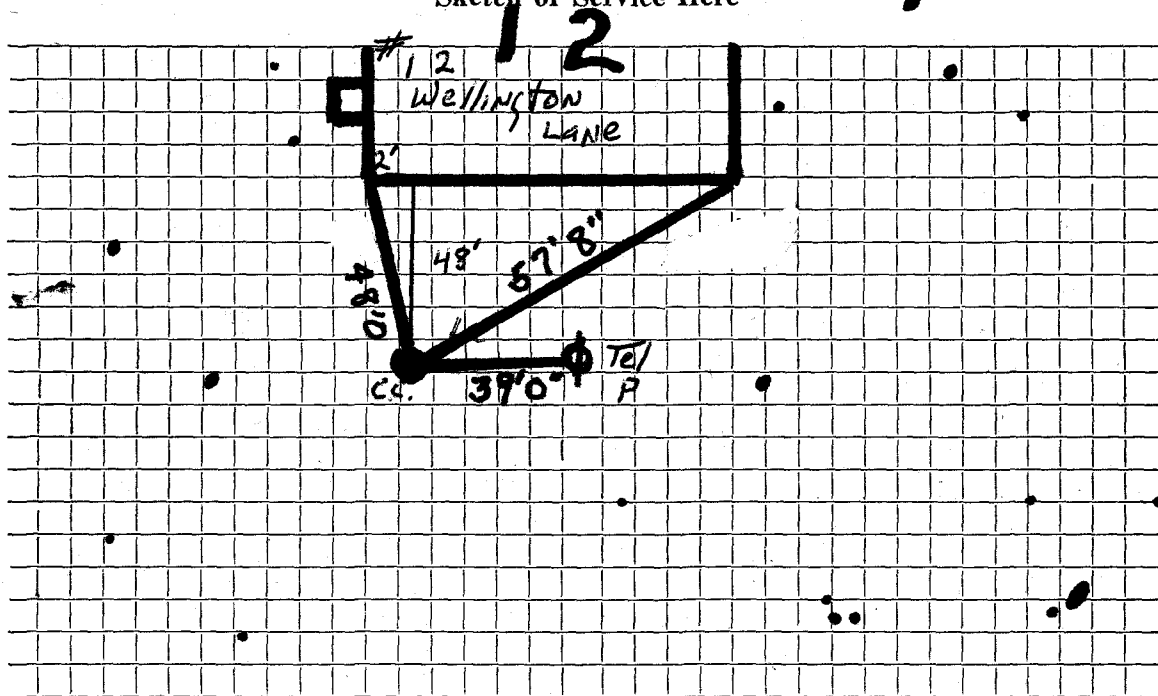

Connection made in Street. Work completed

Remarks:

.....

.....