

WATER SERVICE RECORD

Name David Zaloga

Service No. 48

Address 16 Wellington Lane

Location Mail; 58 Cross St. Andover, Mass.

Repair—Renewal—New Service

Contractor - Russell Sibley WO #4852

MAY 9 1977


Date		Material	Amount		Total		Date	Amount
9/10/76		labor	89.	56			9-18-76 Deposit	300.00
		10%OH	8.	96	98.	52	5-9-77 Refund	124.35
	30'	3/4" Copper @ .65			19.	50		175.25
	1	3/4" Curb @ 13.70			13.	70		
	1	3/4" Corp.			10.	53		
	1	box and rod			15.	40		
	1	hr. trucking			3.	00		
	2	hr. shovel @ 6.50			13.	00		
	1/2	hr. loader @ 4.00			2.	00		
					175.	65		
10-19-76		45' 3/4" Copper						

DATE _____

TOWN OF LEXINGTON — BOARD OF PUBLIC WORKS

WATER DIVISION

Sketch of Service Here

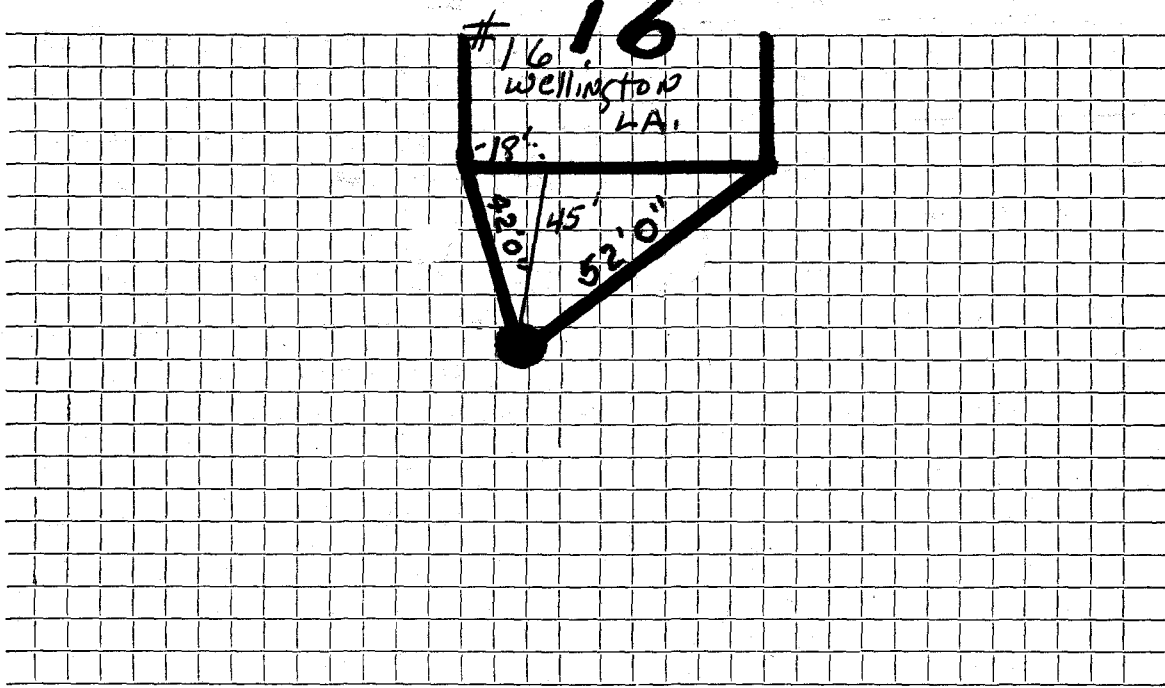

Connection made in Street. Work completed

Remarks:
.....
.....