




DATE \_\_\_\_\_

TOWN OF LEXINGTON — BOARD OF PUBLIC WORKS  
WATER DIVISION

Sketch of Service Here

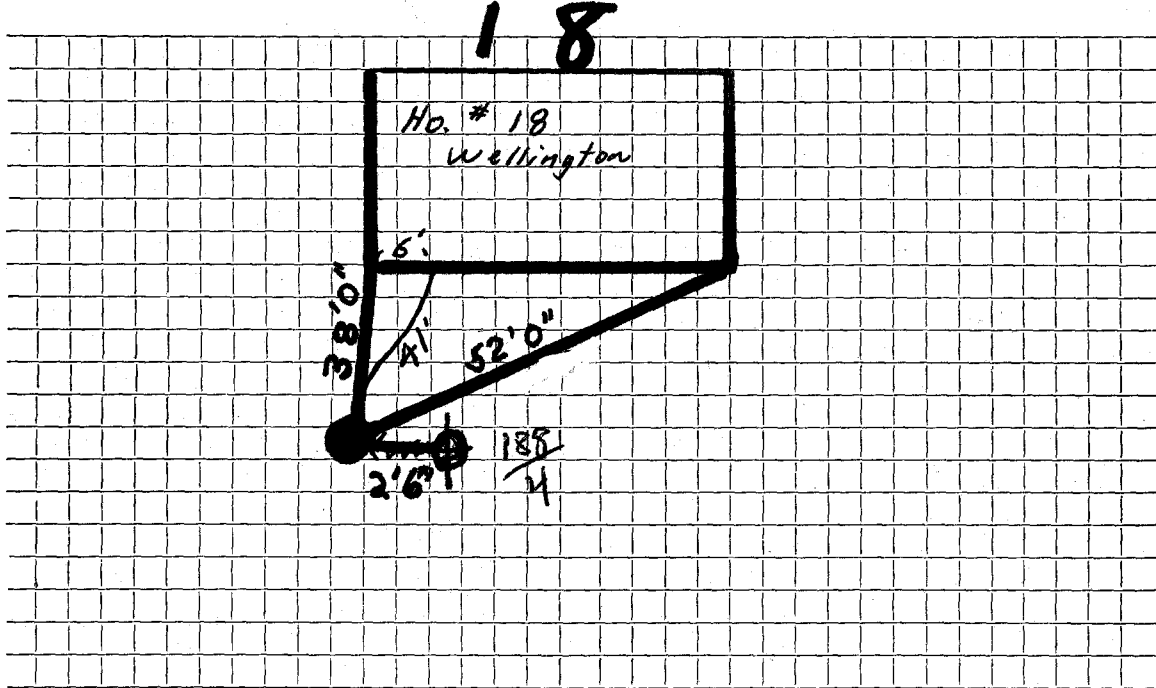

Connection made in *Wellington... Lane..* Street.

Work completed .....

Remarks: .....

.....  
.....