

## WATER SERVICE RECORD

Name Louis J. DiLuna

Service No. 71

Address 19 Wellington Lane #VE

#1845

Location

Repair—Renewal—New Service W.O.#7422 DeFlice #1239

JAN 27 1969


Date	Material	Amount	Total	Date	Amount
9-24-68	Labor	21.07		10-29-68	79.97
	10% O.H.	2.11	23.18		
15	1" copper tubing @.99		14.85		
	1" Corp Cork		10.66		
	1" Curb Cork		14.43		
	Box & Rod		5.10		
1 1/2	hr. Town Shovel @6.50		9.75		
1/2	hr Loader @4.00		2.00		
			<u>79.97</u>		
10-29-68	246 1" Copper tubing				

DATE \_\_\_\_\_

# TOWN OF LEXINGTON — BOARD OF PUBLIC WORKS

## WATER DIVISION

Sketch of Service Here

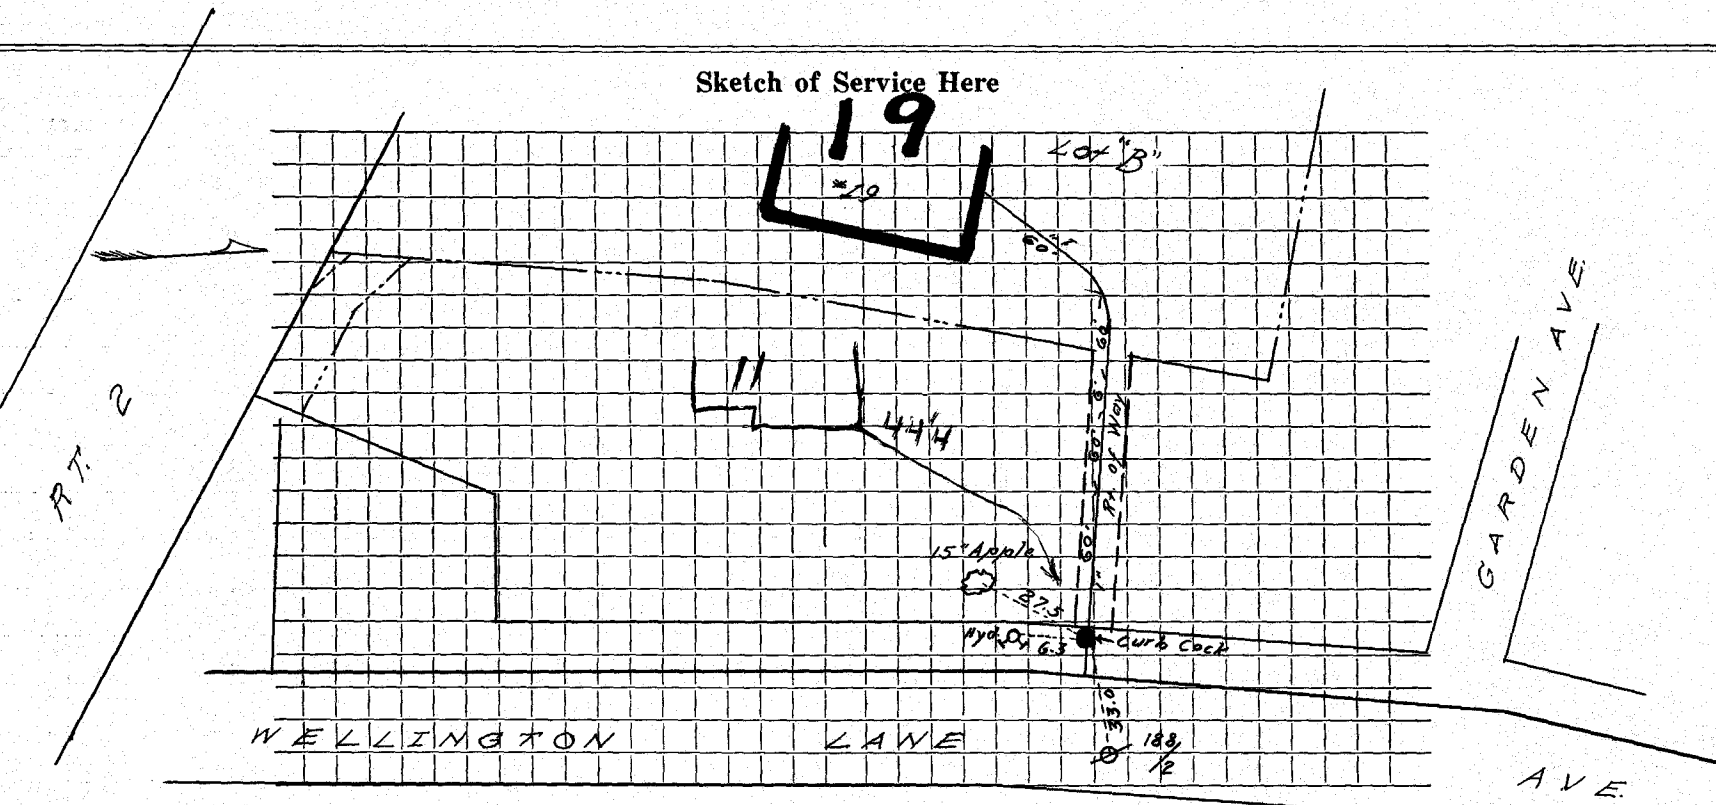

Connection made in ..... Street. Work completed .....

Remarks: .....  
.....  
.....