

WATER SERVICE RECORD

Name *Scott Properties*

Service No. 32

Address 20 Wellington Lane

Location

~~XXXXXXXXXXXX~~ - New Service W.O. # 2585 *Dr. Keller # 2547*

FEB 10 1975


Date	Material	Amount	Total	Date	Amount
10-08-74	Labor	59 01		<i>9-27-74</i>	<i>300 00</i>
10-25-74	Labor	<u>19 49</u>		<i>7-10-74</i>	<i>300 00</i>
		78 50			<i>200 00</i>
	10% O.H.	<u>7 85</u>	86 35		
29'	3/4" Copper Pipe	1 05	30 45		
1	3/4" Corporation	12 45	12 45		
1	3/4" Curb Cork	10 53	10 53		
1	Box and Rod	12 95	12 95		
3	Hrs. Trucking	3 00	9 00		
2	Hrs. Town Shovel	6 50	13 00		
1	Hr. Compressor	5 00	5 00		
1	Hr. Loader	4 00	4 00		
1	Patch 15' x 4'		<u>53 48</u>		
			\$237 21		
<i>10-18-74</i>	<i>38' 3/4 Copper</i>				

DATE _____

TOWN OF LEXINGTON — BOARD OF PUBLIC WORKS

WATER DIVISION

Sketch of Service Here

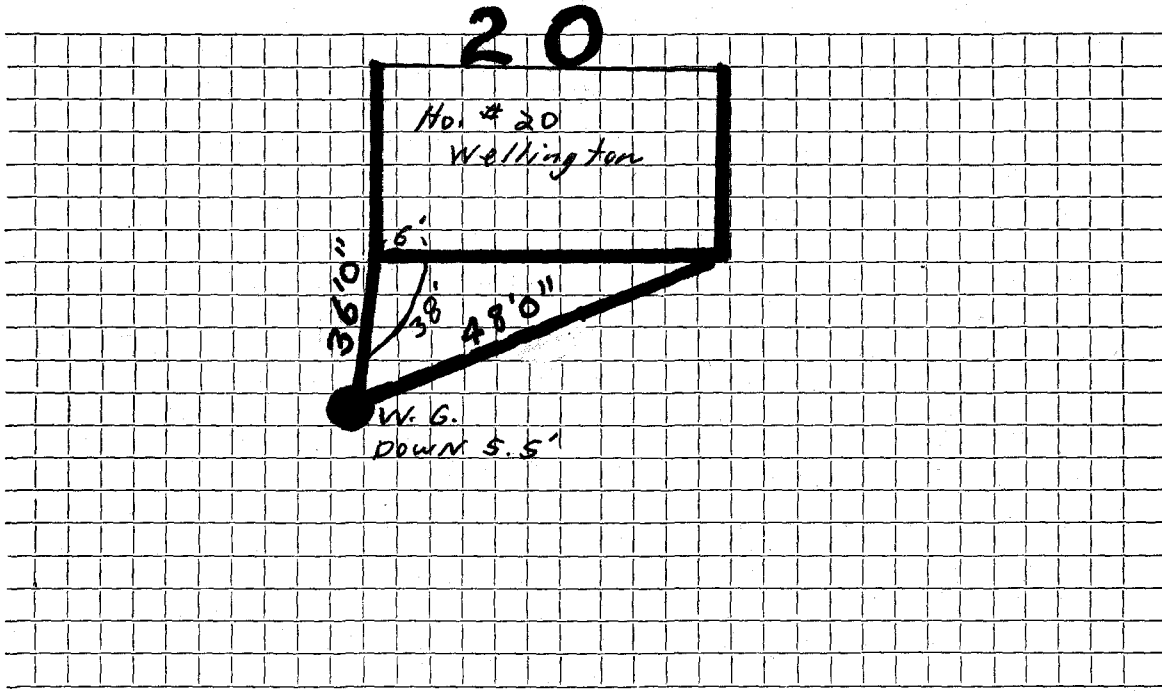

Connection made in *Wellington... Lane*..... Street.

Work completed

Remarks:

.....

.....