

WATER SERVICE RECORD

 6
 Service No.

 #2469
 #2490
 #8833

Name Carl Good

Address 37 Wellington Lane

Location

~~THIS HOUSE IS BEING REBUILT~~
~~THE PERMIT IS~~
~~Regular Service~~ - New Service

W.O. 7421

Great Northern Constructors, Inc.

PERMIT #3525

OCT 6 1980


Date	Material	Amount	Total	Date	Amount
9-23-68	Labor	36.12		9-19-80	Deposit
	10% O.H.	3.61	39.73		\$ 136 44
48	1" Copper @.99		47.52		
	1" Cork Cork		10.66		
	1" Curb Cork		14.43		
	Box & Rod		5.10		
	2 hr. Town Shovel @.6.50		13.00		
	1 1/2 hr Loader@.4.00		6.00		
			136.44		
9-25-80	33' 1" Copper tubing				

DATE _____

TOWN OF LEXINGTON — BOARD OF PUBLIC WORKS

WATER DIVISION

Sketch of Service Here

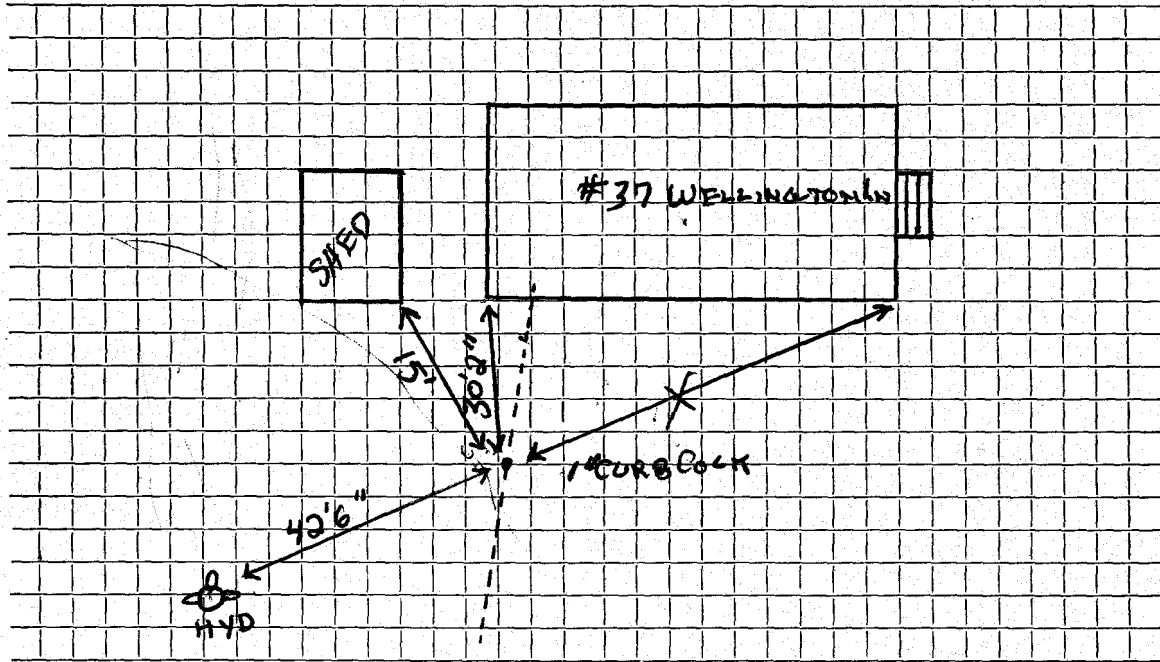

Connection made in Street. Work completed

Remarks: ~~Top down house not to be built~~

~~This service may have been used for water~~