

## WATER SERVICE RECORD

Name Alice Kroll

Service No. 7

Address 51 Wellington Lane

# 675

Location

~~Remix~~ New Service W.O. 7419 Great Northern #3528


OCT 6 1980

Date	Material	Amount	Total	Date	Amount
9-26-68	Labor	33.92		9-23-80	97.59
	10% O.H.	3.39	37.31		
26'	Copper Tubing @.79		20.54		
	Curb Cock		9.57		
	Cock Corp		11.32		
	Box & Rod		5.10		
1 1/8	hr Town Shovel @.6.50		9.75		
1	hr Loader@.4.00		4.00		
			97.59		
9-24-80	38' 3/4" Copper tubing				

DATE \_\_\_\_\_

TOWN OF LEXINGTON — BOARD OF PUBLIC WORKS  
WATER DIVISION

Sketch of Service Here

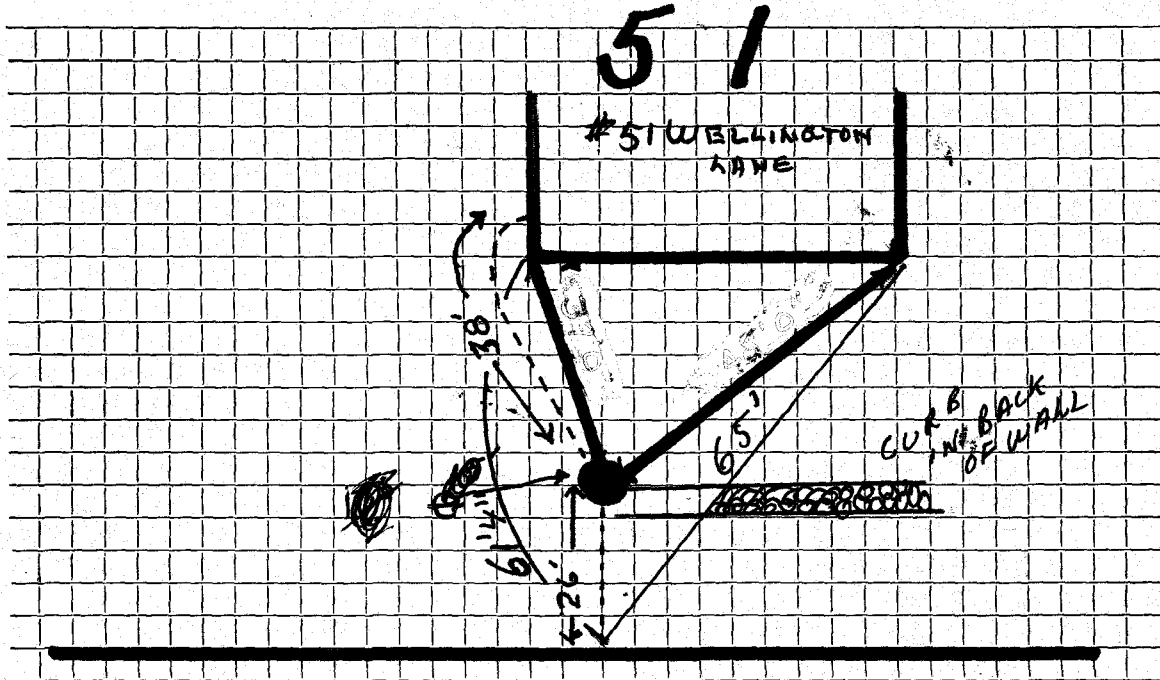

Connection made in ..... Street. Work completed .....

Remarks: .....

.....  
.....