

WATER SERVICE RECORD

Name Franklin Jones

Service No. 59

Address 17 Westminister Avenue

Location

~~RENEW~~—Renewal—~~NEW SERVICE~~

WO #7252

Comm 10-1-62


Date	Material	Amount	Total	Date	Amount	
7/9/62	Labor	68 84		5-19-62	Deposit	150 00
	10% O.H.	6 88	75 72	10-1-62	Returned	35 73
	39' 3/4" Copper Tubing @ .42		16 38			114 27
	1 3/4" Cx 1/2 IWH Stop & Waste		6 17			
	2 Hrs. Town Shovel @ 6.50		13 00			
	1 Hr. Trucking @ 3.00		3 00	7/9/62	Labor	24 10
			114 27		3' 3/4" Copper Tubing @ .42	2 94
					1 3/4" C Corp Cock	4 91
					1 3/4" C Curb Cock	6 28
					1 Box & Rod	4 90
					1 1/2 Straight Tailpiece	50
					1 1/2 Offset Tailpiece	50
					5 X 3 Patch	5 00
				1985	9' 1" Copper	49 13
					1" Corp.	
					3/4" x 1" Reducer	
					3' 3/4" Copper	

DATE _____

TOWN OF LEXINGTON — BOARD OF PUBLIC WORKS

WATER DIVISION

Sketch of Service Here

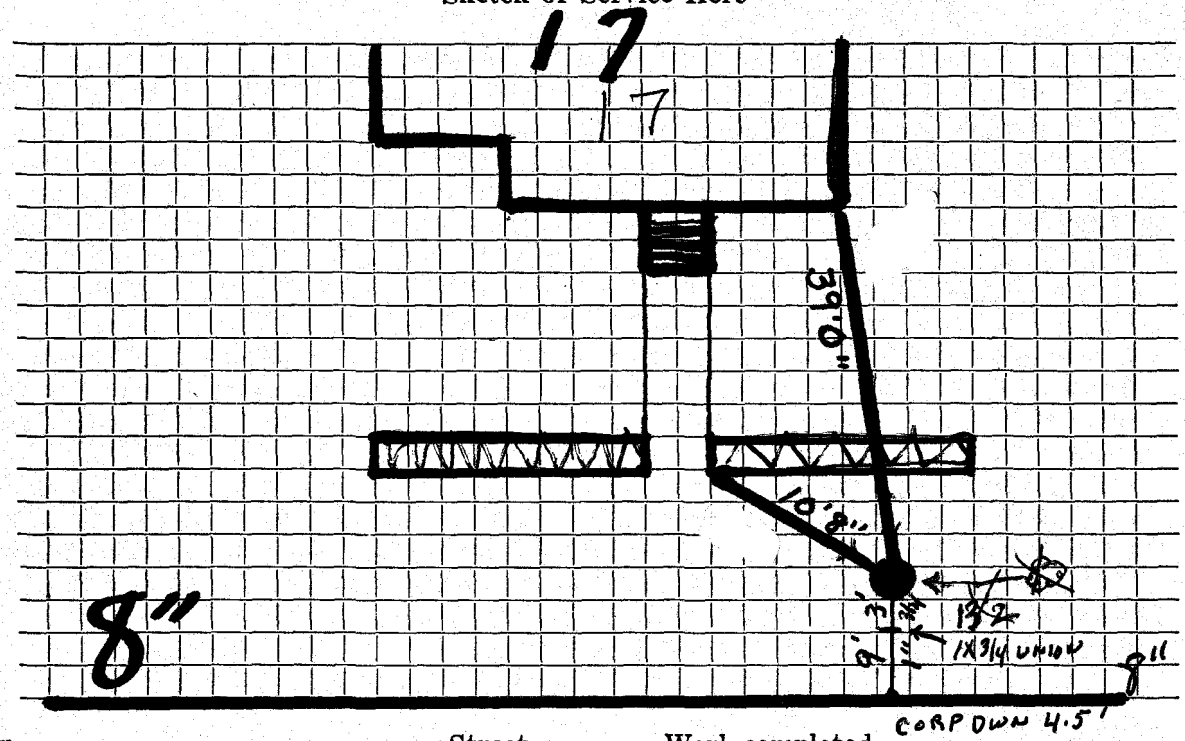

Connection made in Street. Work completed

Remarks:
.....
.....