

WATER SERVICE RECORD

Name **Stephen Aghazarian**

Service No. **60**

Address **4 Westwinstor Avenue**

Location

~~REPAIR SERVICE~~ **New Service W.O. #8044**


Comm 10-28-63

Date	Material	Amount	Total	Date	Amount
7-3-63	Labor	2.31		6-24-63	Deposit 50.00
	10% O.H.	.23	2.54	10-28-63	ReFund 16.09
60'	3/4" Copper tubing @.42		25.20		33.91
1	3/4" C x 1/2" I.W.H. Stop & Waste		<u>6.17</u>		NON CHARGE
			33.91	7-3-63	Labor 2.31
					27' 5/4" Copper tubing @.42 11.34
					4 3/4" G Corp Cock 4.91
					1 3/4" C Curb Cock 6.28
					1 Box & Rod <u>4.90</u>
				1985	1' 1" Copper 29.74
					1" Corp.
					3/4" x 1" Reducer

TOWN OF LEXINGTON — BOARD OF PUBLIC WORKS

WATER DIVISION

Sketch of Service Here

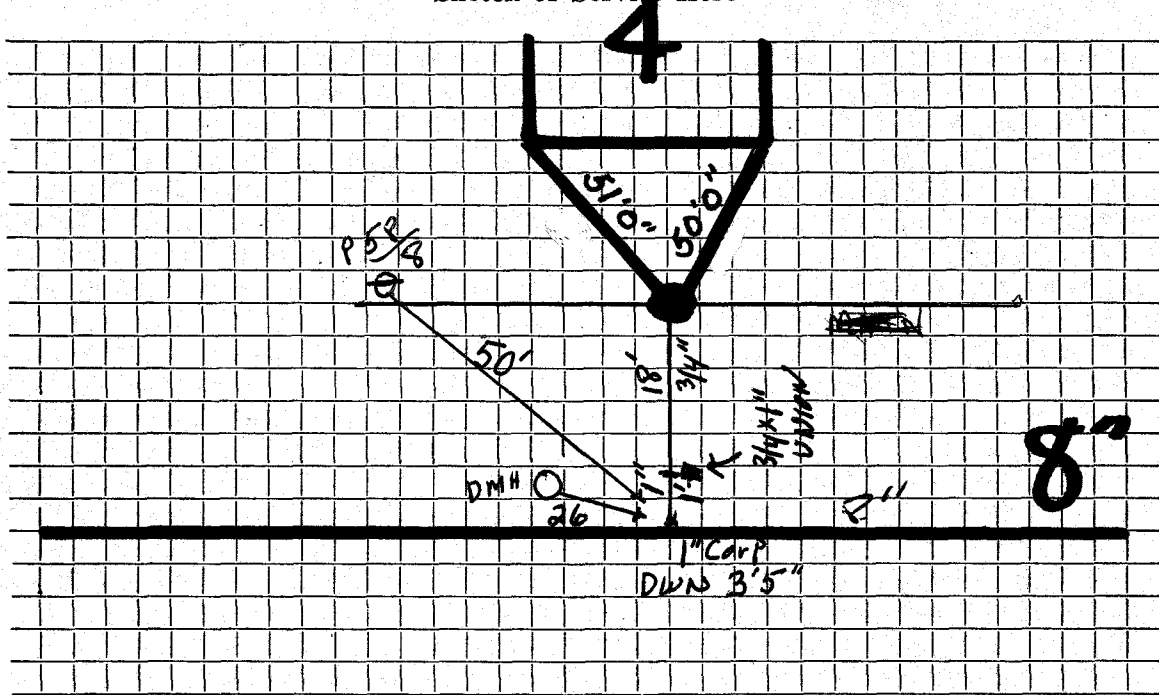

Connection made in Street. Work completed

Remarks:

.....

.....