

WATER SERVICE RECORD

Name George Bolton

Service No. 21

Address 11 Weston Street

3174

Location

~~Road - R.R. 2000~~ - New Service

Comm 5-4-59


Date	Material	Amount	Total	Date	Amount
4-9-59	Labor	3 50		4-6-59	Deposit 100 00
	10% O. H.	35	3 85	5-4-59	Refund 56 58
70'	3/4" Copper Tubing @.3666		25 66		43 12
1	3/4" C x 1/2 I.W.H. Stop & Waste		5 84		NON CHARGE
1	3/4" C 3 part Union		2 27	4-9-59	Labor 10 98
2	Hrs. Trucking @.75		1 50	9'	3/4" Copper Tube @.3666 3 30
	1 x 3 Patch		4 00	1	3/4" C Corp Cock 4 64
			43 12	1	3/4" C Curb Cock 6 03
				1	Box & Rod 5 00
				1	1/2 Straight Tailpiece 50
				1	1/2 Offset Tailpiece 50
					39 95

DATE 8-3-1999

TOWN OF LEXINGTON — BOARD OF PUBLIC WORKS

WATER DIVISION

Sketch of Service Here

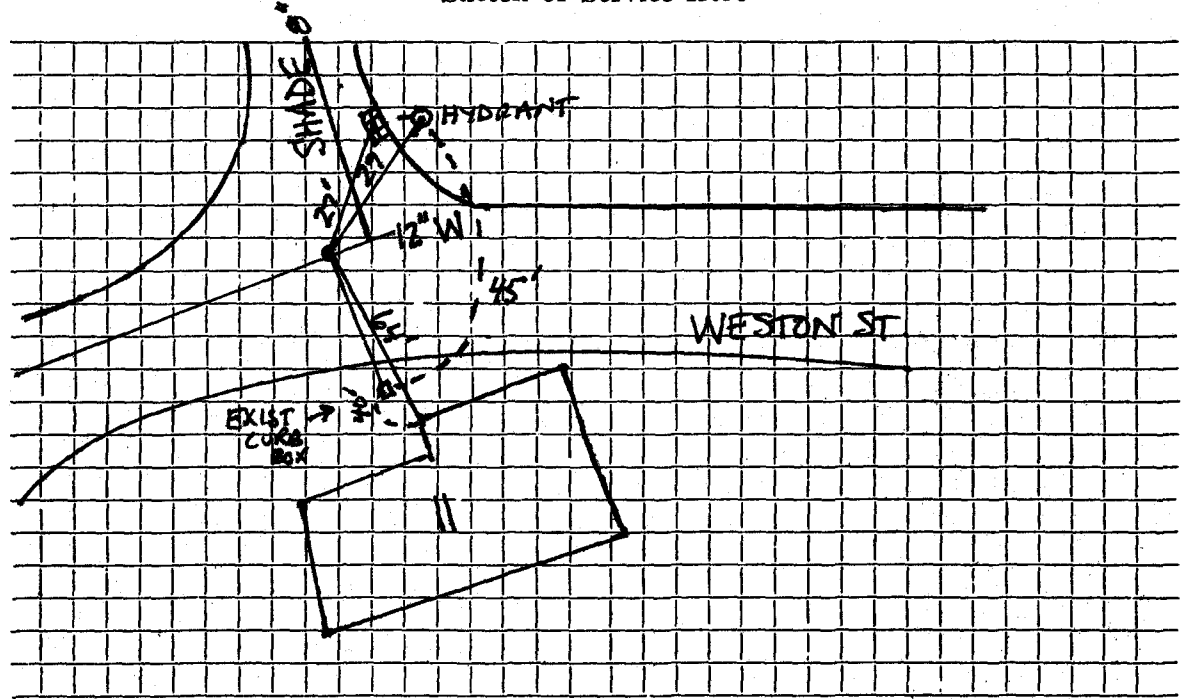

Connection made in 12" MAIN ON WESTON/SHADE INT. Street.

Work completed NEW CORPORATION, UNION.....

Remarks:
.....
.....

WATER SERVICE RECORD

Name George Bolton

Service No. 21

Address 11 Weston Street

3174

Location

~~RAMP - RAMP~~ - New Service

Comm 5-4-59

Date	Material	Amount	Total	Date	Amount
4-9-59	Labor	3 50		4-6-59	Deposit 100 00
	10% O. H.	35	3 85	5-4-59	Retard 56 88
70'	3/4" Copper Tubing @.3666		25 66		43 12
1	3/4" C x 1/2 I.W.H. Stop & Waste		5 84		NON CHARGE
1	3/4" C 3 part Union		2 27	4-9-59	Labor 10 98
2	Hrs. Trucking @.75		1 50		9' 3/4" Copper Tube @.3666 3 30
	4 x 3 Patch		4 00		1 3/4" C Corp Cock 4 64
			43 12		1 3/4" C Curb Cock 6 03
					1 Box & Rod 5 00
					1 1/2 Straight Tailpiece 50
					1 1/2 Offset Tailpiece 50
					39 95

DATE _____

TOWN OF LEXINGTON — BOARD OF PUBLIC WORKS

WATER DIVISION

Sketch of Service Here

A large grid of graph paper, consisting of 20 columns and 20 rows, intended for sketching service details.


Connection made in Street. Work completed

Remarks:
.....
.....

DATE 8-3-1999

TOWN OF LEXINGTON — BOARD OF PUBLIC WORKS
WATER DIVISION

Sketch of Service Here

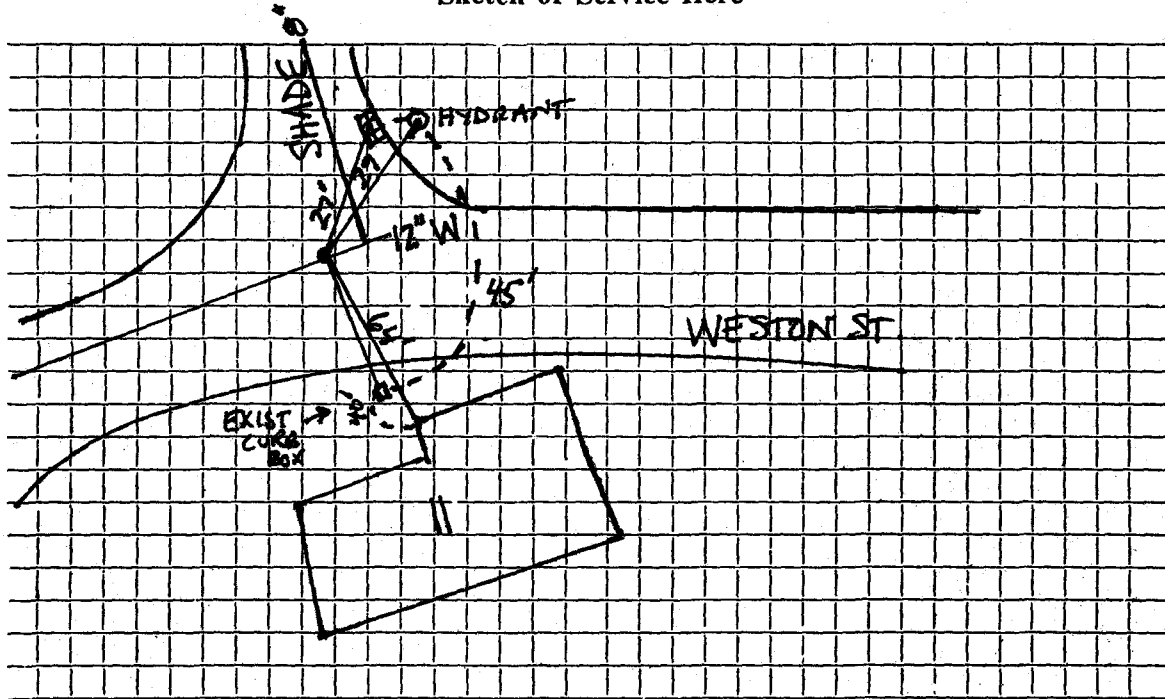

Connection made in 12" MAIN ON WESTON/SHADE INT Street.

Work completed NEW CORPORATION, UNION

Remarks:

.....

.....