




DATE 8-5-1999

# TOWN OF LEXINGTON — BOARD OF PUBLIC WORKS WATER DIVISION

Sketch of Service Here

ACTUAL  
VIEW IN GROUND.

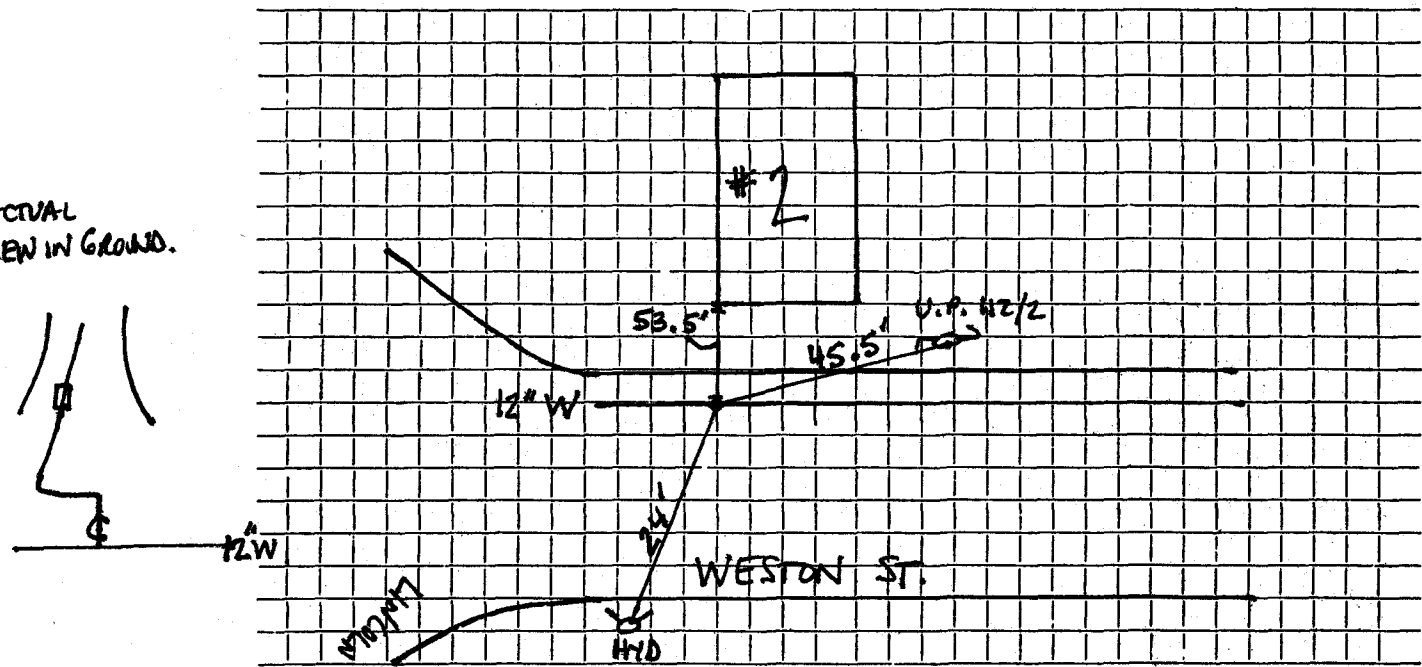

Connection made in 12" MAIN ON WESTON ST. Street. Work completed NEW CORPORATION, UNION

Remarks: (SEE PICTURE @ LEFT) CORPORATION TIED INTO 12" MAIN, COPPER TAKES LEFT TURN PARALLEL TO MAIN THEN HEADS UP DRIVEWAY TO CURB BOX

#4046

WATER SERVICE RECORD

Name William Catley

Service No. 221

Address 2 Weston Street

Location Lexington, Mass.

~~Repair~~ New Service


Com. 11-13-51

Date	Material	Amount	Total	Date	Amount
10/6/51	Labor	4 03	4 03	9-14-51	Deposited 65 00
	10% overhead		40	11-13-51	Refunded 7 15
	45' - 3/4" copper tubing @ .326	14 67			<u>NON CHARGE</u> 57 85
	1 - 3/4" C x 1/2 I.W.H. stop & waste	4 00	10/6/51	Labor	12 53
	2 hrs. Littlefield shovel @ 7.00	14 00	45' - 3/4" copper tubing @ .326		14 67
	1 hr. trucking	75	1 - 3/4" C. corp-cock		4 33
	patching 20 x 3	20 00	1 - 3/4" C x 3/4" C. curb-cock		4 67
			57 85	1 box and rod	4 68
				1 - 1/2 offset tail piece	50
				1 - 1/2 straight tail piece	50
				3 hrs. Littlefield shovel @ 7.00	21 00
				1 hr. trucking	75
					<u>63 63</u>

DATE \_\_\_\_\_

TOWN OF LEXINGTON — BOARD OF PUBLIC WORKS  
WATER DIVISION

Sketch of Service Here

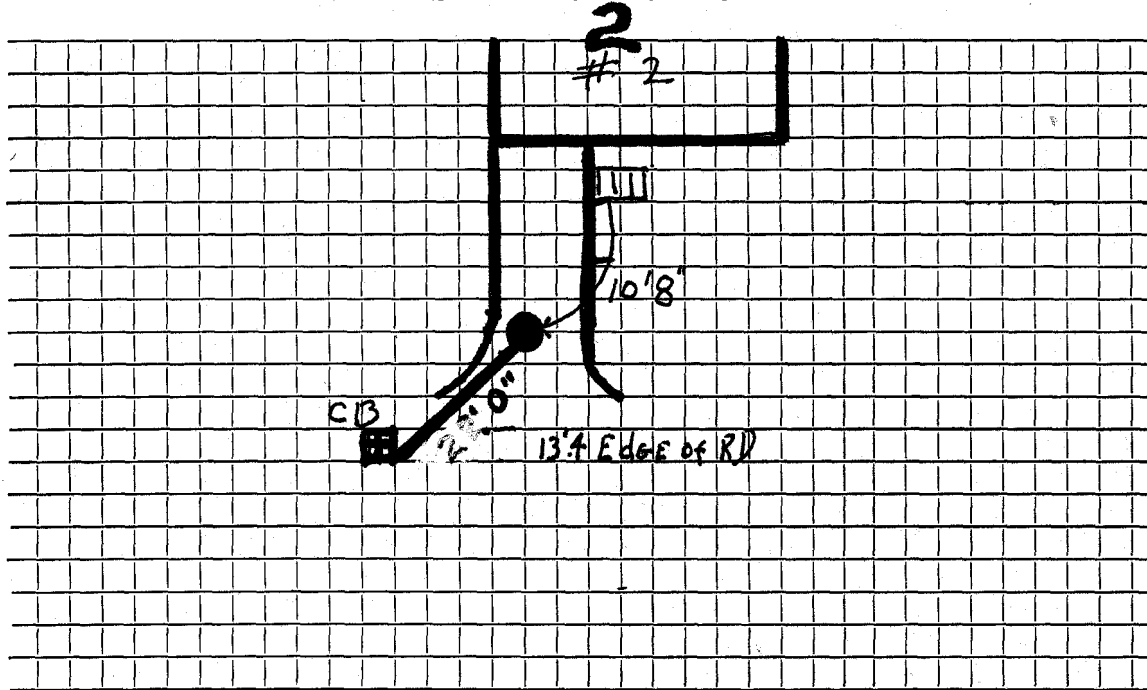

Connection made in ..... Street. Work completed .....

Remarks: .....

.....

.....