

WATER SERVICE RECORD

Name

Service No.

Address 3 WESTON STREET

Location CORPORATION OF 12" MAIN ON WESTON ST.

Repair ~~Renewal~~ - New Service WATER MAIN CLEANING & LINING PROJECT C99-02 / Biszko Co.


Date	Material	Amount	Total	Date	Amount
				8/2/1999	
				 	
				17'	1" COPPER TUBING BTW CORPORATION & UNION
				1	CORPORATION
				1	UNION

DATE 8-2-1999

TOWN OF LEXINGTON — BOARD OF PUBLIC WORKS

WATER DIVISION

Sketch of Service Here

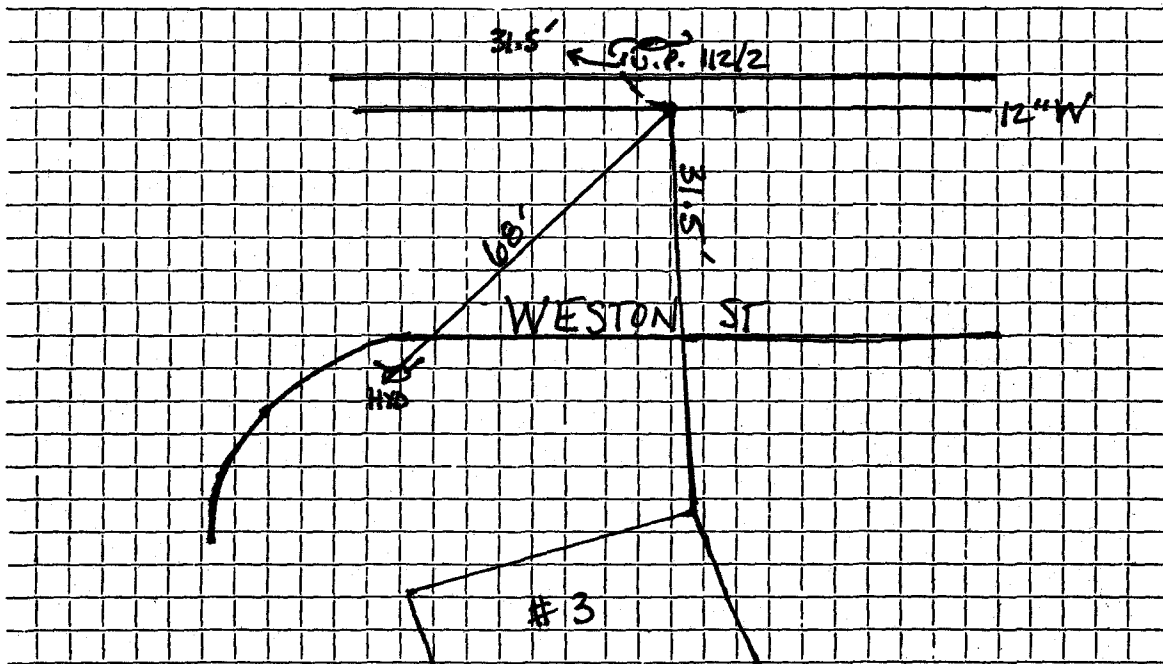

Connection made in Street. Work completed

Remarks:
.....
.....

WATER SERVICE RECORD

5980

Name Frank Bertulla

Service No.

73

Address 3 Weston Street

Location

~~XXXXXX~~ - New Service

Comm 8-1-60

Date	Material	Amount	Total	Date	Amount
6-7-60	Labor	2.05		5-24-60 5-24-60	50.00
	10% O.H.	.21	2.26	*-1-60	28.13
32'	3/4" copper tubing @ .42		13.44		21.87
1	3/4" Cx 1/2 IWH Stop & Waste		6.17		
			21.87		
				6-7-60	NON CHARGE
					Labor
					1.94
				12'	3/4" Copper tubing @ .42
				1	3/4" C Corp Cock
				1	3/4" C Curb cock
				1	Box & Rod
				1	1/2 Straight tailpiece
				1	1/2 Offset tailpiece
					24.17


* Applied to 5th # 79

DATE _____

TOWN OF LEXINGTON — BOARD OF PUBLIC WORKS

WATER DIVISION

Sketch of Service Here

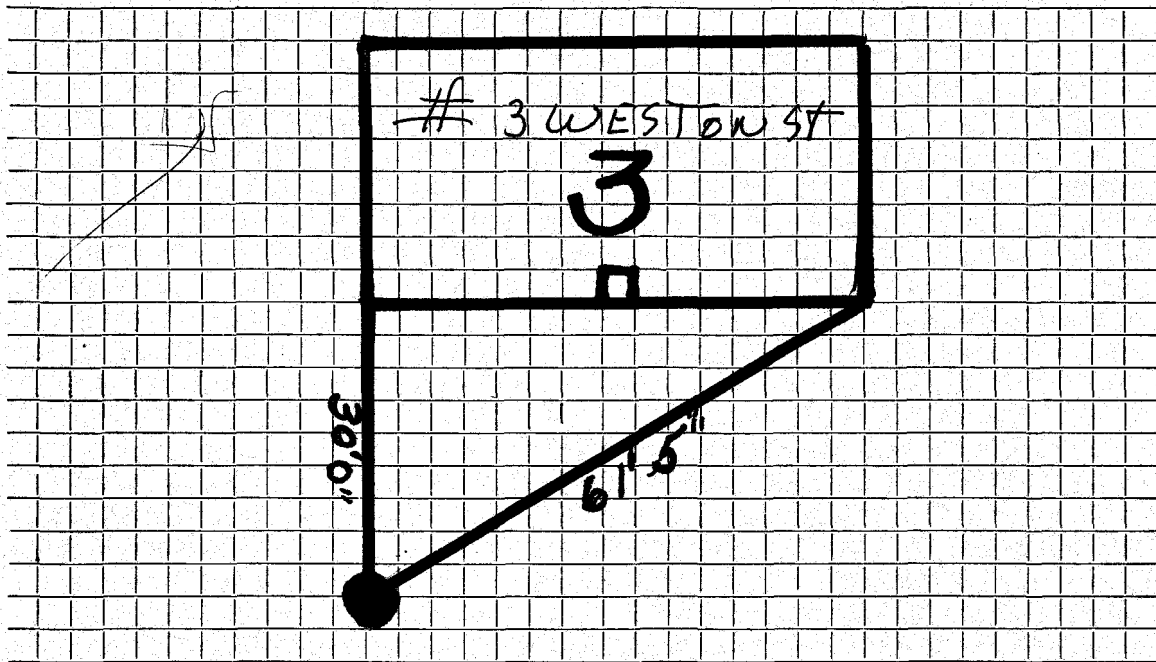

Connection made in Street. Work completed

Remarks:

.....

.....