

Name Forrest Knapp
 Address 4 Weston Street, Lexington

Service No. ~~103~~ 2939
 # 6141

Location 4 Weston Street

Kind of Pipe Size Size of Main

~~Repair~~ ~~Renewal~~ New Service

Location

Date 1941	Material	Amount	Total	Date	Amount
June 4, <i>Com 9/15/41</i>	4 hrs. @ 60¢	2 40		September 17, 1941	30 18
	10% Overhead	24	2 64	<i>Paid</i>	
	41' 3/4" Copper tubing @ 19¢		7 79		
	1 3/4" C.x 1/2" I.S. & W.		2 50		
	2 hrs. trucking @ 75¢		1 50		
	Trench repairs		12 00		
	Construction charge		3 75		
			<u>30 18</u>	<i>Sept 9, 1941</i>	
	Labor				

DATE _____

TOWN OF LEXINGTON—BOARD OF PUBLIC WORKS

WATER DIVISION

The undersigned applies for a supply of water at No. _____ St. and hereby agrees to comply with the rules and regulations as now, or at any future time, established by the Board of Selectmen.

Am't. of Estimate \$ _____


Owner _____

Am't. Paid \$ _____

Address _____

Builder _____

Sketch of Service Here

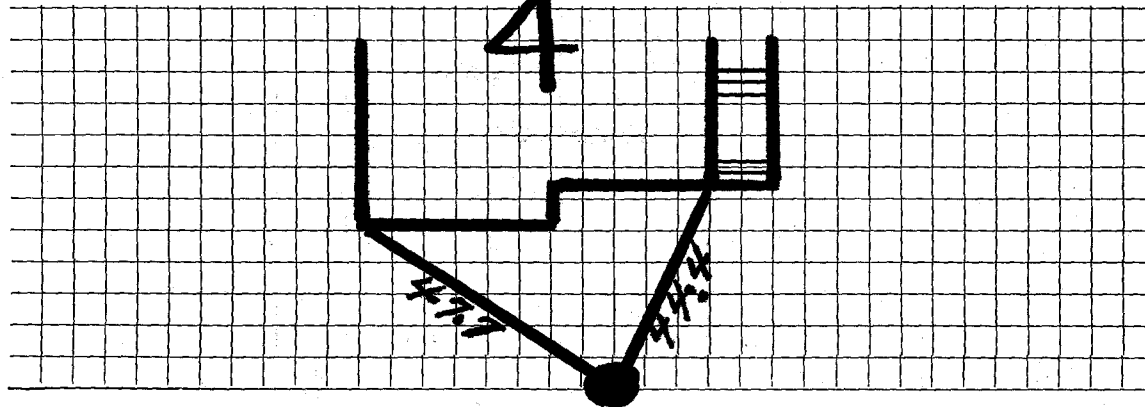

Connection made in _____ Street.

Work completed _____ 19


Remarks:

DATE 8-2-1999

TOWN OF LEXINGTON — BOARD OF PUBLIC WORKS

WATER DIVISION

Sketch of Service Here

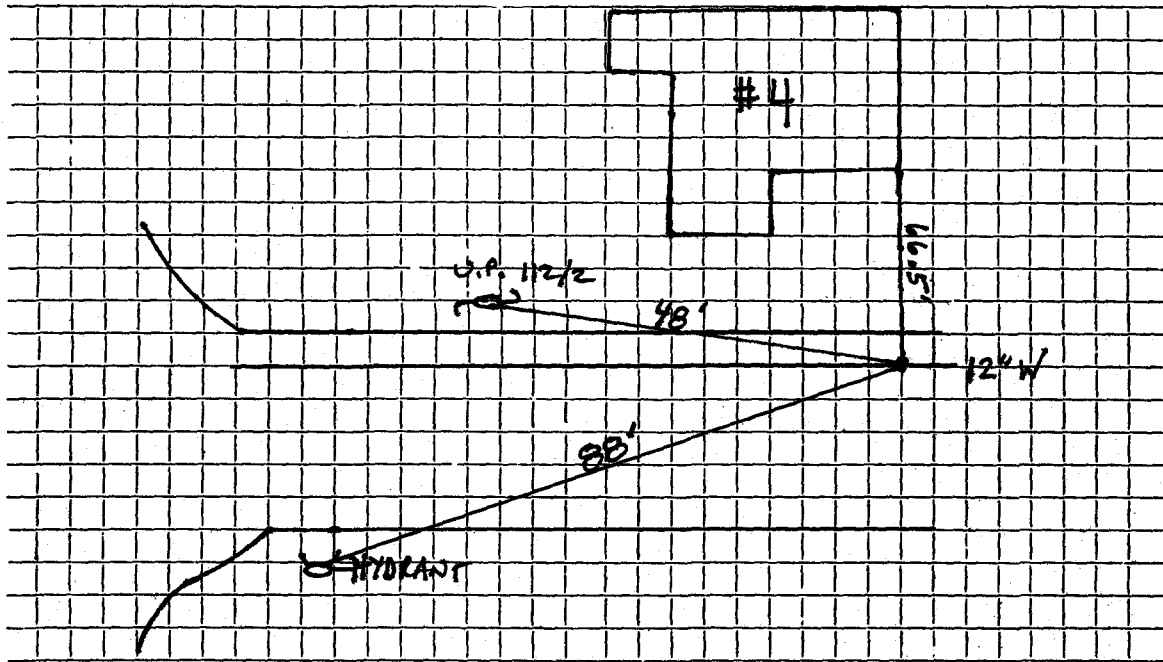

Connection made in 12" MAIN IN WESTON ... Street.

Work completed NEW CORPORATION, UNION

Remarks: