

Water Service Record

Name _____ Service No. _____

Address Westview Cemetery Building Proj.

Location _____


Repair Renewal - New Service Emergency Repair

| Date | Material | Amount | Total | Date | | Amount |
|----------|--------------------|--------|-------|------|--|--------|
| 01/11/24 | Replaced 2" | | | | | |
| | pipe and coupling. | | | | | |
| | | | | | | |
| | | | | | | |
Date: 01/11/24

TOWN OF LEXINGTON - BOARD OF PUBLIC WORKS
WATER DIVISON

SKETCH OF SERVICE HERE → Repair

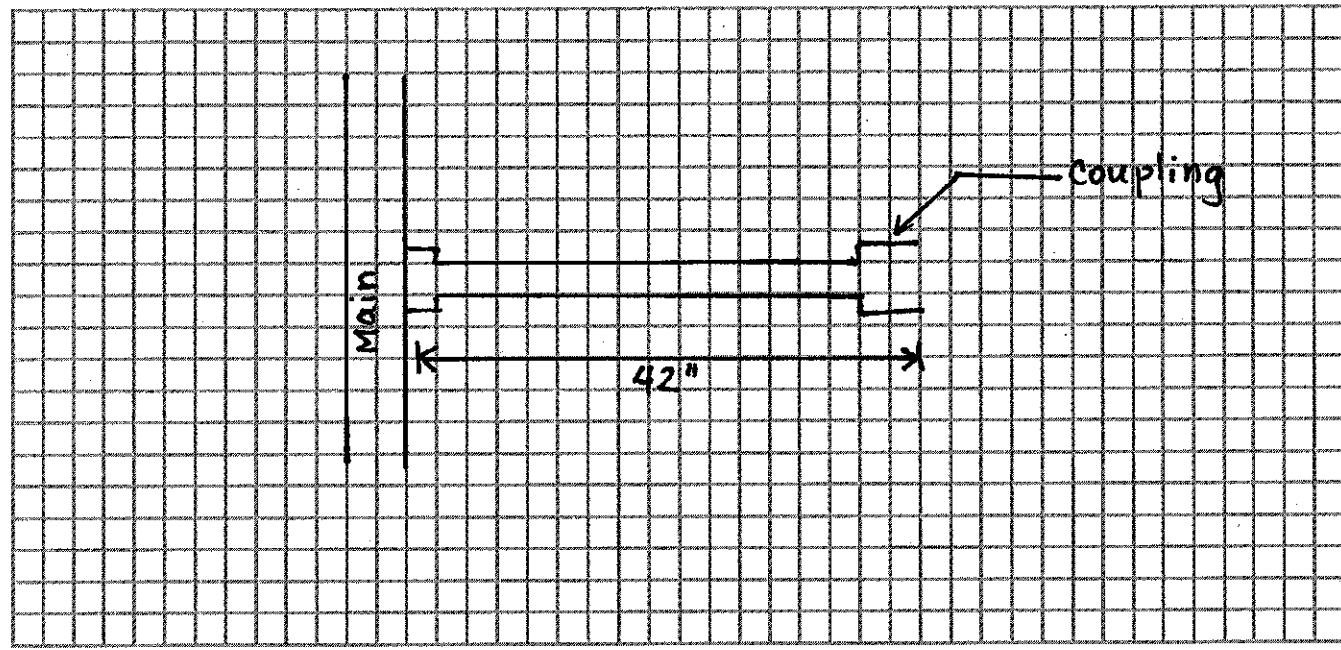

Connection made in:

Street.

Work completed:

Remarks: Installed/Repaired by Construction Dynamics