

Name Westview Cemetery

Service No. 61

Address <sup>17</sup> Westview Street

Location <sup>17</sup> Westview Street

Kind of Pipe

Size

Size of Main

~~Repair~~ ~~Renewal~~ New Service

Can 5/22/50

Location

Date	Material	Amount	Total	Date	Amount
Sept. 30, '49	Labor	11 60	11 60		
	10% Overhead		1 16		
	4' - 2" C. L. Pipe @.45		1 80		
	Trucking 1 hr. @.75		75		
			15 31		
				Sept. 30, '49	
				28' - 1" Copper Tubing @.28	7 84
				4' - 2" C. L. Pipe @.45	1 80
				4 - 1" C. Corp-cocks @ 4.62	18 48
				1 - 2" T. H. Gate Valve	9 25
				1 - 1" C x 2" I 4-way Branch	12 18
				1 - Box & Rod	3 75
				1 - Pit Cover & Frame	8 65
				4' - 30" Clay Pipe	12 00
	Labor			Trucking 1 hr. @.75	75
					84 70

No Deposit  
Cash

No Charge

June 22 '50

DATE \_\_\_\_\_

TOWN OF LEXINGTON – BOARD OF PUBLIC WORKS

**WATER DIVISION**

The undersigned applies for a supply of water at No..... St. and hereby agrees to comply with the rules and regulations as now, or at any future time, established by the Board of Selectmen.

Am't of Estimate \$.....

Owner .....


Am't Paid \$.....

Address .....


Builder .....

.....

**Sketch of Service Here**

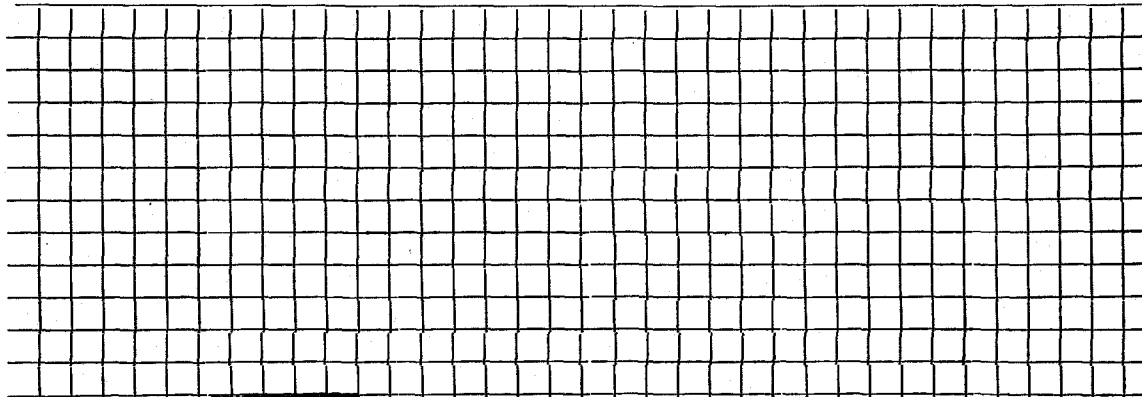

Connection made in .....

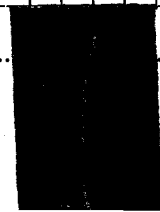

..... Street.

Work completed .....19

Remarks: