


TOWN OF LEXINGTON — BOARD OF PUBLIC WORKS

WATER DIVISION

Sketch of Service Here

10/94 McLaughlin

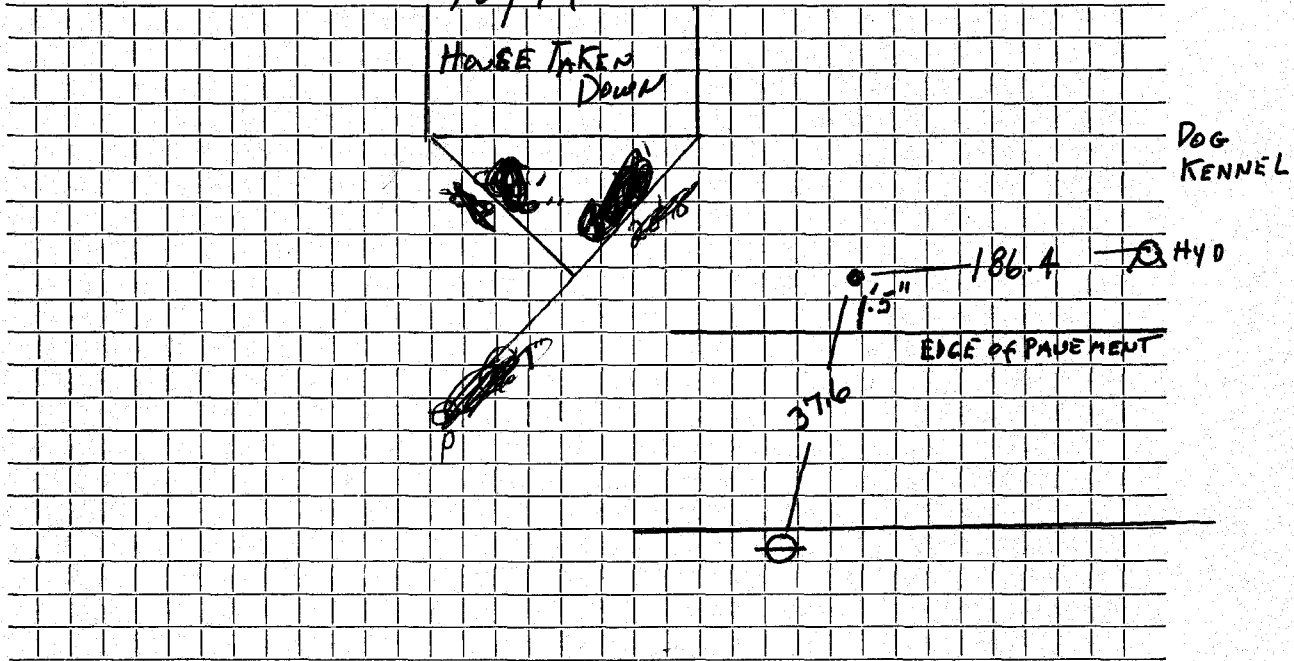

Connection made in Street. Work completed

Remarks: Tie off old card

.....
.....