

WATER SERVICE RECORD

Name

Service No.

Address

#60 Westview Street

Location

Repair—Renewal—New Service


J.M. Lucente #2383

Date		Material	Amount	Total	Date	Amount
12-4-	73	82' - 2" Copper				
					11-23-'73	
					33'	2" Copper
					1	2" Corp Cock
					1	2" Curb Cock
					1	Gate Box
					1	12" X 2" Saddle

DATE _____

TOWN OF LEXINGTON — BOARD OF PUBLIC WORKS

WATER DIVISION

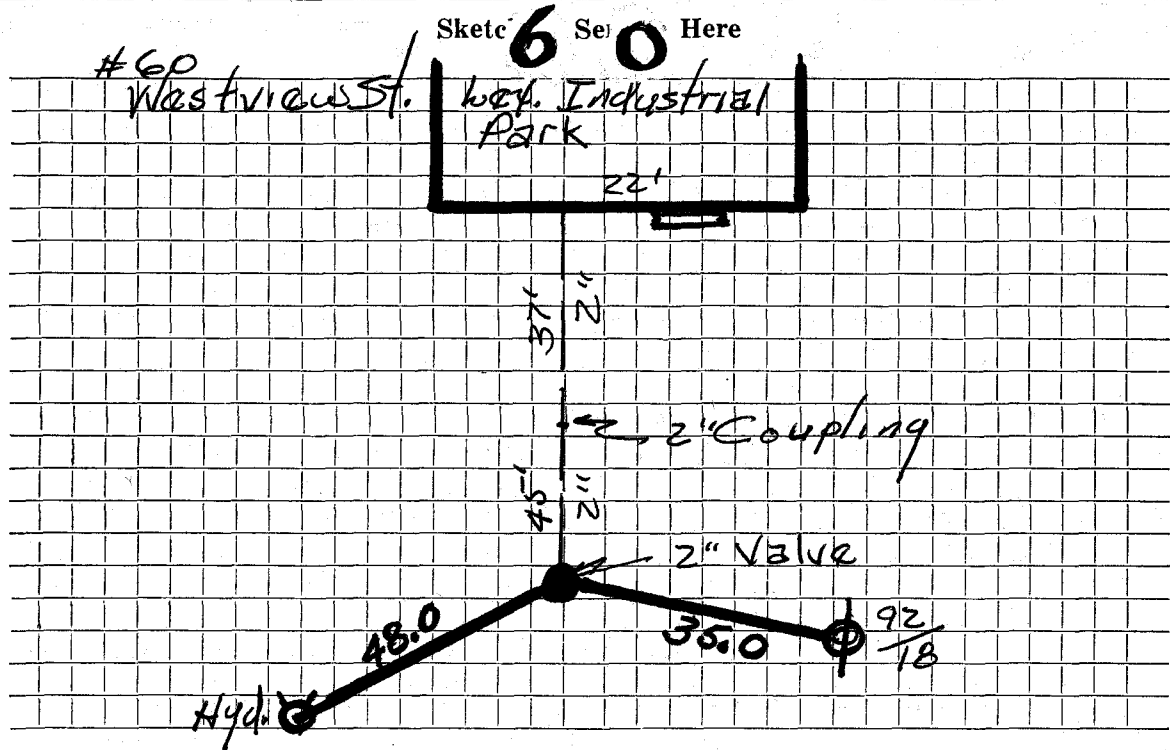

Connection made in Street. Work completed

Remarks:
.....
.....