

WATER SERVICE RECORD

Name Gustavo HurtadoService No. 34Address 63 Westview Street#7627

Location

~~WATER SERVICE~~ - New Service*Com. 3-15-54*


Date	Material	Amount	Total	Date	Amount
3/1/54	Labor	1 75		2-25-54 Deposited	25 00
	10% overhead	18	1 93	3-15-54 Refunded	(2 62)
	35' - 3/4" copper tubing@.3629	12 70		<u>NON CHARGE</u>	22 38
	1 - 3/4"C x 1/2 I.W.H. stop & waste	4 00	3/1/54 Labor		7 75
	1 hr. trucking		75	10' - 3/4" copper tubing@.3629	3 63
	patching 3 x 3		<u>3 00</u>	1 - 3/4" C. corp-cock	4 33
			22 38	1 - 3/4"C x 3/4"C. curb-cock	4 67
	TRENCH DUG BY OWNER:			1 box and rod	3 90
				1 - 1/2 straight tail pc.	50
				1 - 1/2 offset tail pc.	50
				2 hrs. Littlefield shovel @ 7.50	15 00
				1 hr. trucking	<u>75</u>
					41 03

DATE _____

TOWN OF LEXINGTON — BOARD OF PUBLIC WORKS

WATER DIVISION

Sketch of Service Here

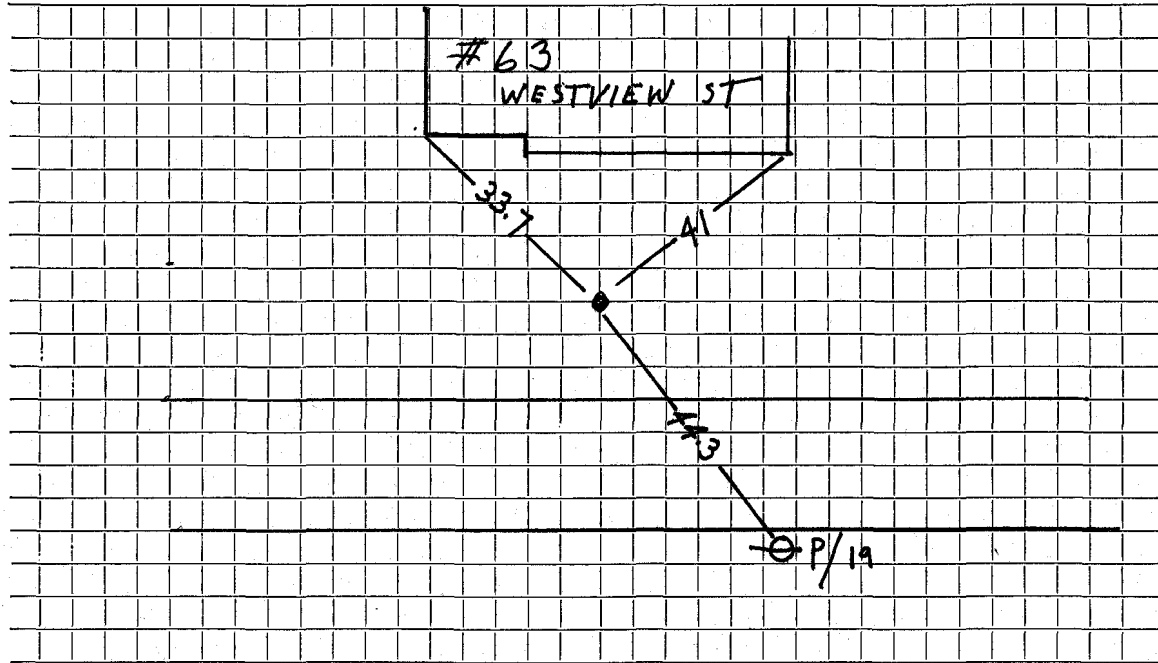

Connection made in Street. Work completed

Remarks:

.....

.....