

Name William DeFelice

Service No. 234

Address 80 Westview Street

Lexington, Mass.

Location 80 Westview Street

Kind of Pipe

Size

Size of Main

~~XXXXXXXXXXXX~~ New Service

Com. 12-5-49

Location

Date	Material	Amount	Total	Date	Amount
Nov. 4, '49	Labor	2 55	2 55	Nov 1, '49	30 00
	10% Overhead		26	Mar 27 '50	2 96
	28' - 3/4" Copper Tubing @.24	6 72			32 96
	1 - 3/4" C x 1/2" I.W.H. S&W	3 29		Oct. 22, '49	6 90
	1 - 3/4" C x 3/4" C Union (3pts)	1 39		23' - 3/4" Copper Tubing @.24	5 52
	Trucking 1 hr. @.75	75		1 - 3/4" C Corp-cock	3 15
	Patching 18 x 3	18 00		1 - 3/4" C x 3/4" C Curb-cock	3 85
			32 96	1 - Box & Rod	3 75
				1 - 1/2" Offset Tail Piece	37
				1 - 1/2" Straight Tail Piece	37
				Littlefield Shovel 2 hrs. @7.00	14 00
				Trucking 1 hr. @.75	75
					38 66
	Labor				

Bill sent 12-22-49

DATE _____

TOWN OF LEXINGTON – BOARD OF PUBLIC WORKS

WATER DIVISION

The undersigned applies for a supply of water at No..... St. and hereby agrees to comply with the rules and regulations as now, or at any future time, established by the Board of Selectmen.

Am't of Estimate \$.....

Owner


Am't Paid \$.....

Address

Builder

.....

Sketch of Service Here

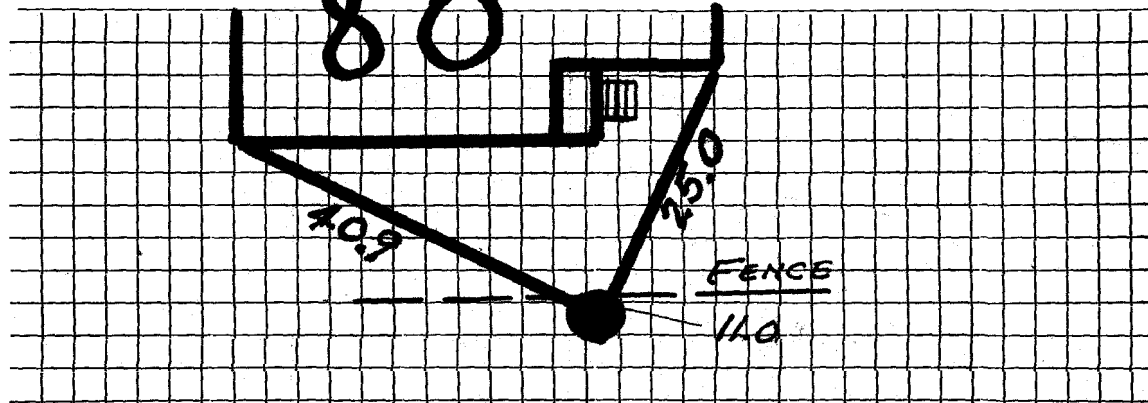

Connection made in Street.

Work completed19

Remarks: