

Name Louis Boulter

Service No. 229

Address 87 Westview Street

#1543

Lexington, Mass.

Location 87 Westview Street

Kind of Pipe

Size

Size of Main

~~REPAIR HIGHWAY~~ New Service

Com. 12-5-49

Location

Date	Material	Amount	Total	Date	Amount
Oct. 22, '49	Labor	1 35	1 35	Oct 22 '49	20 00
	10% Overhead		14	Mar 17, 1952	3 09
	44' - 3/4" Copper Tubing @ .24	10 56			No Charge
	1 - 3/4" C x 1/2" I.W.H. S&W	3 29		Oct. 22, '49	Labor 2 40
	Trucking 1 hr. @ .75	75		12' - 3/4" Copper Tubing @ .24	2 88
	Patching 7 x 3	7 00		1 - 3/4" C Corp-cock	3 15
		23 09		1 - 3/4" C x 3/4" C Curb-cock	3 85
				1 - Box & Rod	3 75
				1 - 1/2" Offset Tail Piece	37
				1 - 1/2" Straight Tail Piece	37
				Littlefield Shovel 1 hr. @ 7.00	7 00
				Trucking 1 hr. @ .75	75
	Labor				24 52

Bill sent 12-23-49

DATE _____

TOWN OF LEXINGTON - BOARD OF PUBLIC WORKS

WATER DIVISION

The undersigned applies for a supply of water at No..... St. and hereby agrees to comply with the rules and regulations as now, or at any future time, established by the Board of Selectmen.

Am't of Estimate \$.....

Owner


Am't Paid \$.....

Address

Builder

.....

Sketch of Service Here

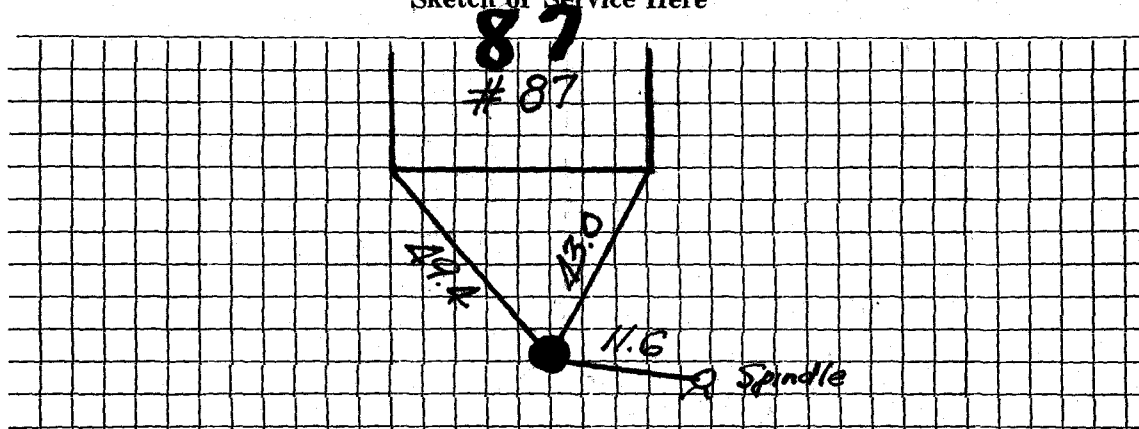

Connection made in Street.

Work completed19

Remarks: