


DATE 3/5/2020

TOWN OF LEXINGTON — BOARD OF PUBLIC WORKS
WATER DIVISION

Sketch of Service Here

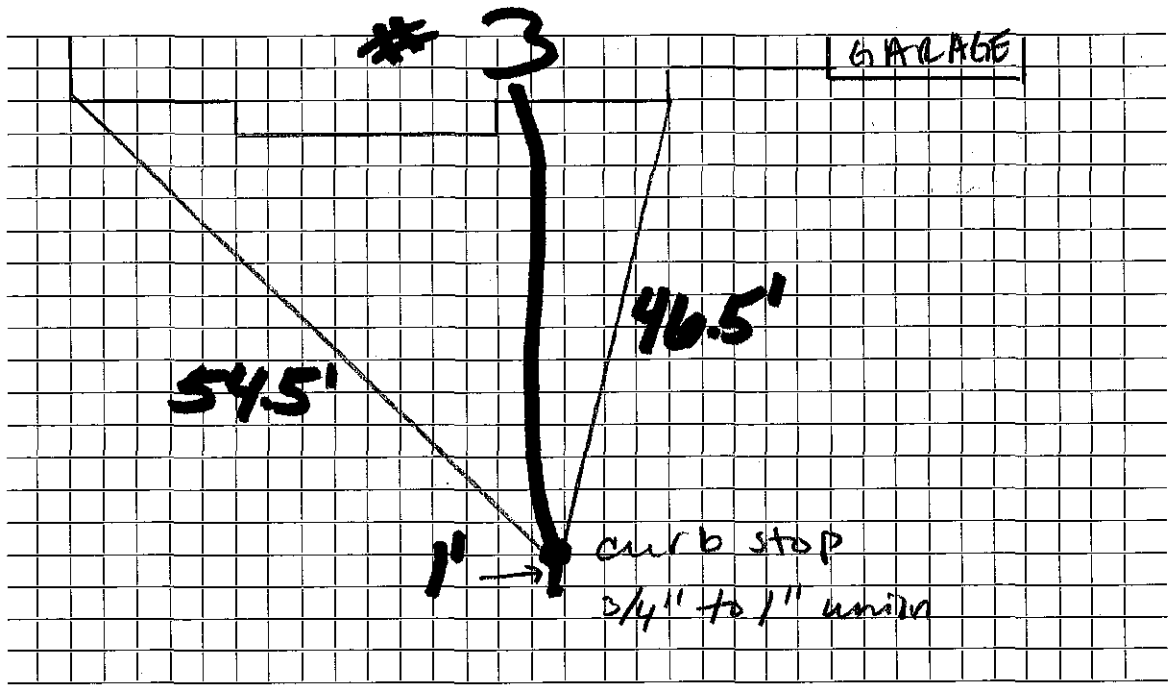

Connection made in Westwood Street. Work completed

Remarks: