

WATER SERVICE RECORD

#155

Name Universal Develop. Corp.

Service No. 11

Address 11 Westwood Road

Location

~~Repair Work~~ - New Service

*Com. 2-8-54*


Date	Material	Amount	Total	Date	Amount
1/12/54	Labor	1 75		1-6-54	Deposited 25 00
	10% overhead	18	1 93	2-8-54	Refunded 11 99
	45' - 3/4" copper tubing@.3629		16 53		<u>NON CHARGE</u> 23 01
	1 -3/4"C x 1/2 I.W.H.stop& waste		4 00	1/12/54	Labor 3 11
	1 hr. trucking		75		8' - 3/4" copper tubing@.3629 2 90
			<u>23 01</u>		1 -3/4"C. corp-cock 4 33
	TRENCH DUG BY OWNER:				1 -3/4"C x 3/4"C. curbcock 4 67
					1 -box and rod 3 90
					1 -1/2 straight tail pc. 50
					1 -1/2 offset tail pc. 50
					1 hr. trucking 75
					<u>20 66</u>

DATE \_\_\_\_\_

TOWN OF LEXINGTON — BOARD OF PUBLIC WORKS

**WATER DIVISION**

Sketch of Service Here

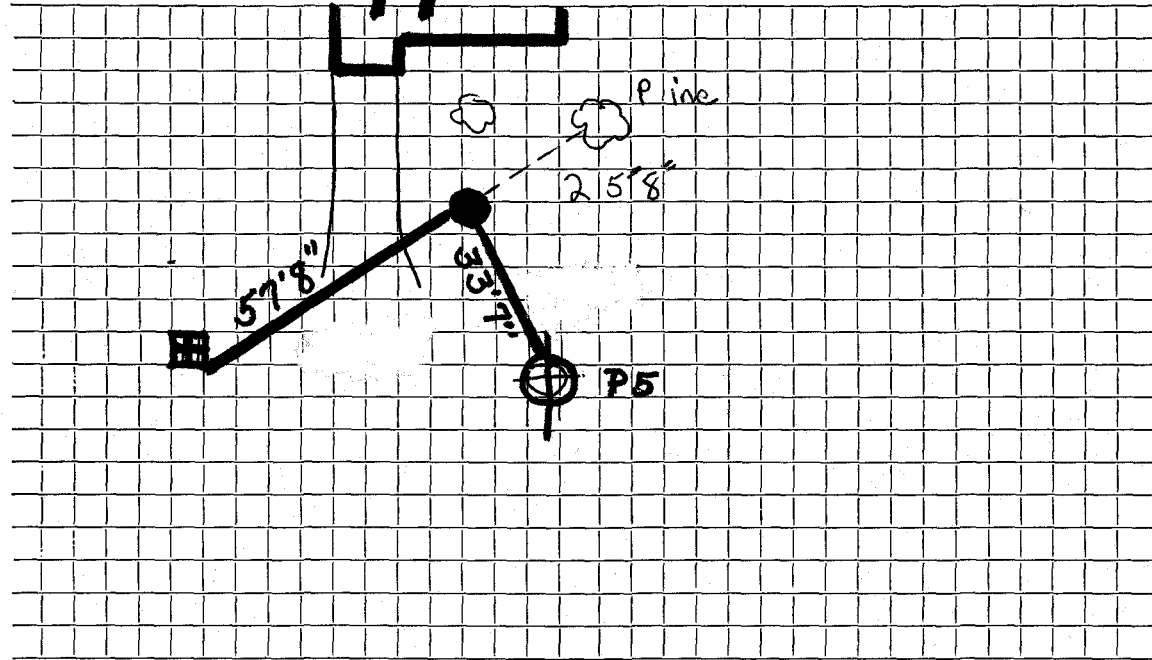

Connection made in ..... Street.      Work completed .....

Remarks: .....

.....

.....