

## WATER SERVICE RECORD

Name Universal Development Corporation

Service No. 17

Address 15 Westwood Road

11 1932

Location

~~Repair~~ ~~Renew~~ New Service

Com. 5-3-54


Date	Material	Amount	Total	Date	Amount
3/18/54	Labor	2 62		1-12-54 Deposited	25 00
	10% overhead	26	2 88	5-3-54 * Re-fund	(11 62)
	45'-3/4" Copper tubing @.35		15 75	NON CHARGE	23 38
	1-3/4 Cx 1/2 I.W.H. Stop & waste		4 00	3/18/54 Labor	2 63
	1 hr trucking		75	15'-3/4" Copper tubing @.35	5 25
			23 38	1-3/4 C.Corp cock	4 33
	TRENCH DUG BY OWNER:			1-3/4" Cx 3/4" C curb cock	4 67
				1- Box & rod	3 90
				1-1/2 Straight tail piece	50
				1-1/2 Offset tail piece	50
				1 hr trucking	75
					22 53
				* \$10.75 made payable to Town	
				to apply our water rates,	
				accounts B-159-11, B-159-10	

DATE \_\_\_\_\_

TOWN OF LEXINGTON — BOARD OF PUBLIC WORKS

WATER DIVISION

Sketch of Service Here

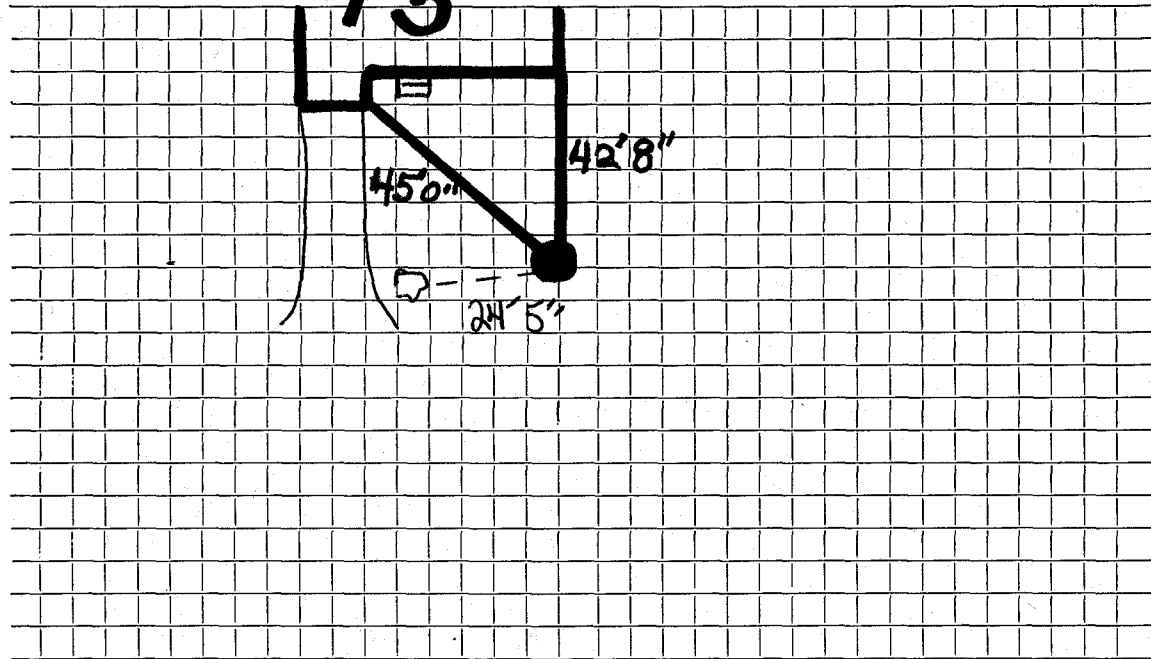

Connection made in ..... Street. Work completed .....

Remarks: .....  
.....  
.....