

WATER SERVICE RECORD

#5393
#5394

Name Universal Development Corporation

Service No. 18

Address 16 Westwood Road

Location

~~TRENCH DUG BY OWNER~~ New Service

Am 5-3-54


| Date | Material | Amount | Total | Date | Amount |
|---------|-----------------------------------|--------|-------|-----------------------------|-------------------------|
| 3/11/54 | Labor | 3 36 | | 1-12-54 | Deposited 25 00 |
| | 10% overhead | 34 | 3 70 | 5-3-54 | Refunded (9 05) |
| | 50'-3/4" Copper tubing @.35 | | 17 50 | | <u>NON CHARGE</u> 25 95 |
| | 1-3/4" Cx 1/2 I.W.H. Stop & waste | 4 00 | 4 00 | 3/11/54 | Labor 3 94 |
| | 1 hr trucking | | 75 | 25'-3/4" Copper tubing @.35 | 8 75 |
| | | | 25 95 | 1-3/4" C.Corp Cock | 4 33 |
| | TRENCH DUG BY OWNER: | | | 1-3/4" Cx 3/4" C.curb cock | 4 67 |
| | | | | 1- Box & rod | 3 90 |
| | | | | 1-1/2 Straight tail piece | 50 |
| | | | | 1-1/2 Offset tail piece | 50 |
| | | | | 1 hr trucking | 75 |
| | | | | | <u>27 34</u> |

DATE _____

TOWN OF LEXINGTON — BOARD OF PUBLIC WORKS

WATER DIVISION

Sketch of Service Here

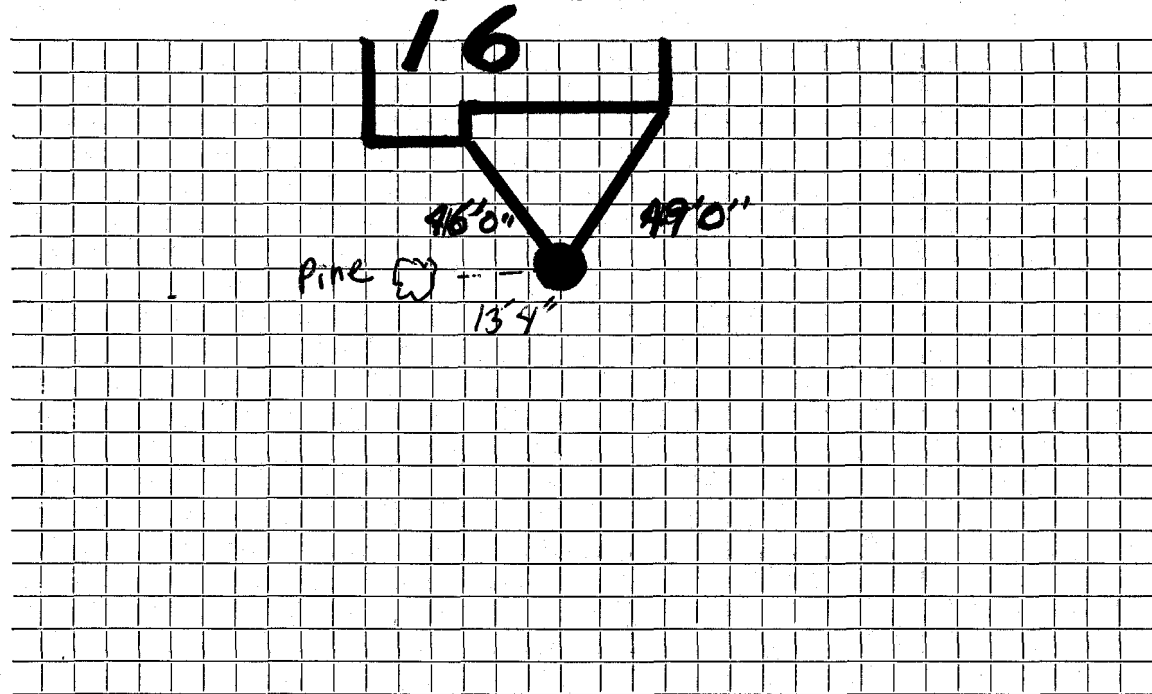

Connection made in Street. Work completed

Remarks:

.....

.....