

WATER SERVICE RECORD

Name **Universal Development Corp.**

Service No. **19**

Address **17 Westwood Road**

Location

~~XXXXXXXXXXXX~~ - New Service

*Com. 2-8-54*


Date	Material	Amount	Total	Date	Amount
1/15/54	Labor	1 75		1-12-54	Deposited 35 00
	10% overhead	18	1 93	2-8-54	Refunded 10 17
	50' - 3/4" copper tubing @ .3629	18 15			<u>NON CHARGE</u> 24 83
	1 - 3/4" C x 1/2 I.W.H. stop & waste	4 00		1/15/54	Labor 9 34
	1 hr. trucking		75		10' - 3/4" copper tubing @ .3629 3 63
			24 83		1 - 3/4" C. corp-cock 4 33
	TRENCH DUG BY OWNER:				1 - 3/4" C x 3/4" C. curb-cock 4 67
					1 box and rod 3 90
					1 1/2 offset tail pc. 50
					1 1/2 straight tail pc. 50
					1 hr. trucking 75
					<u>27 62</u>

DATE \_\_\_\_\_

TOWN OF LEXINGTON — BOARD OF PUBLIC WORKS

WATER DIVISION

Sketch of Service Here

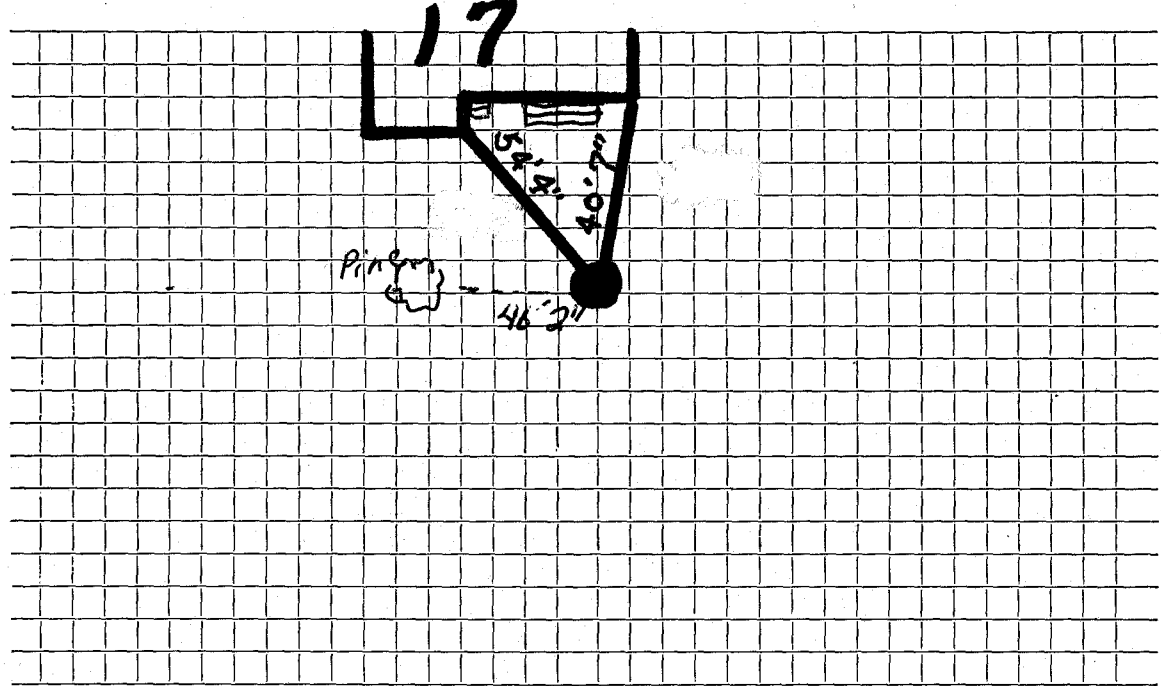

Connection made in ..... Street. Work completed .....

Remarks: .....  
.....  
.....