

WATER SERVICE RECORD

Name **Universal Develop. Corp.**

Service No. **8**

Address **7 Westwood Road**

Location

~~Repairs~~ — New Service

*Com. 2-8-54*


Date	Material	Amount	Total	Date	Amount
1/12/54	Labor	1 75		1-6-54	Deposited 35 00
	10% overhead	18	1 93	2-8-54	Refunded (10 17)
	50' -3/4" copper tubing @ .3629	18 15			<u>NON CHARGE</u> 24 83
	1 -3/4"C x 1/2 I.W.H. stop & waste	4 00		1/12/54	Labor 3 11
	1 -hr. trucking		75		8' -3/4" copper tubing @ .3629 2 90
			24 83		1 -3/4"C. corp-cock 4 33
	TRENCH DUG BY OWNER:				1 -3/4"C x 3/4"C. curb-cock 4 67
					1 box and rod 3 90
					1 -1/2 straight tail pc. 50
					1 -1/2 offset tail pc. 50
					1 hr. trucking 75
					<u>20 66</u>

DATE \_\_\_\_\_

TOWN OF LEXINGTON — BOARD OF PUBLIC WORKS

**WATER DIVISION**

Sketch of Service Here

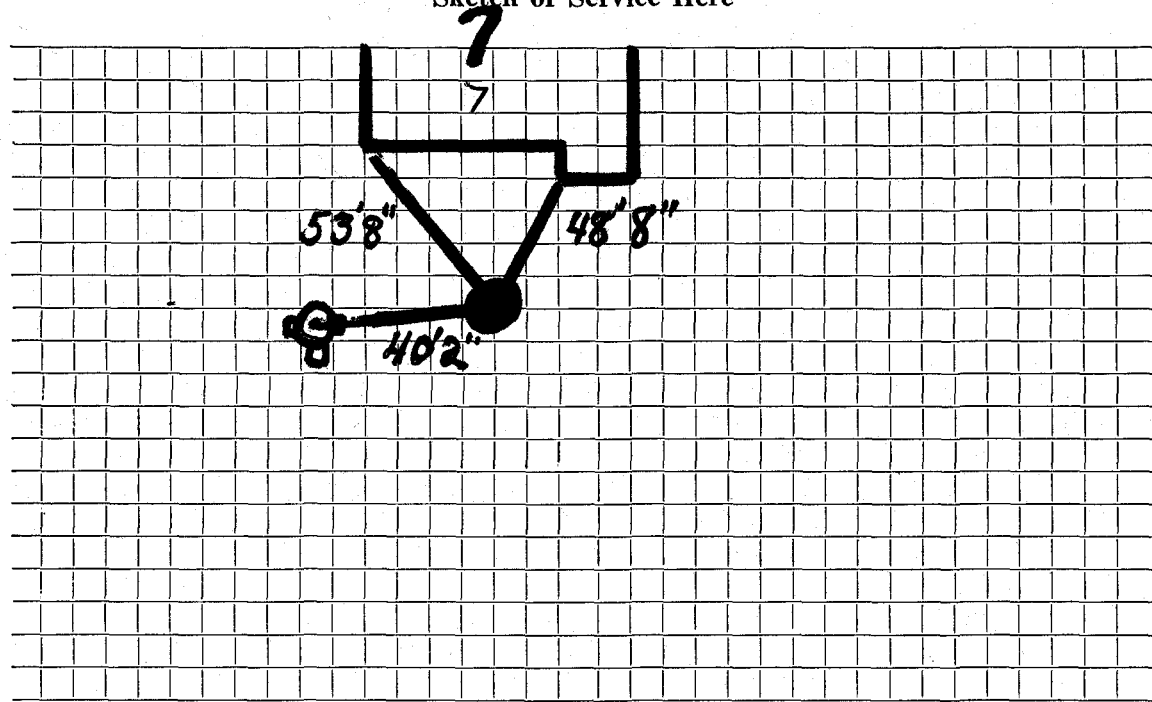

Connection made in ..... Street. Work completed .....

Remarks: .....  
.....  
.....