

4303

WATER SERVICE RECORD

Name **Universal Develop. Corp.**

Service No. **9**

Address **9 Westwood Road**

Location

~~REPAIRS~~ **New Service**

Com. 2-8-54


Date	Material	Amount	Total	Date	Amount
1/12/54	Labor	1 75		1-6-54	Deposited 25 00
	10% overhead	18	1 93	2-8-54	Refunded 8 36
	55' -3/4" copper tubing@.3629	19 96	19 96		<u>NON CHARGE</u> 26 64
	1 -3/4"C x 1/2 I.W.H.stop & waste	4 00	4 00	1/12/54	Labor 3 11
	1 hr. trucking		75		10' - 3/4" copper tubing@.3629 3 63
			26 64		1 -3/4"C. corp-cock 4 33
	TRENCH DUG BY OWNER:				1 -3/4"C. x/4" C.curb-cock 4 67
					1 box and rod 3 90
					1 -1/2offset tail pc. 50
					1 -1/2straight tail pc. 50
					1 hr. trucking 75
					<u>21 39</u>

DATE _____

TOWN OF LEXINGTON — BOARD OF PUBLIC WORKS

WATER DIVISION

Sketch of Service Here

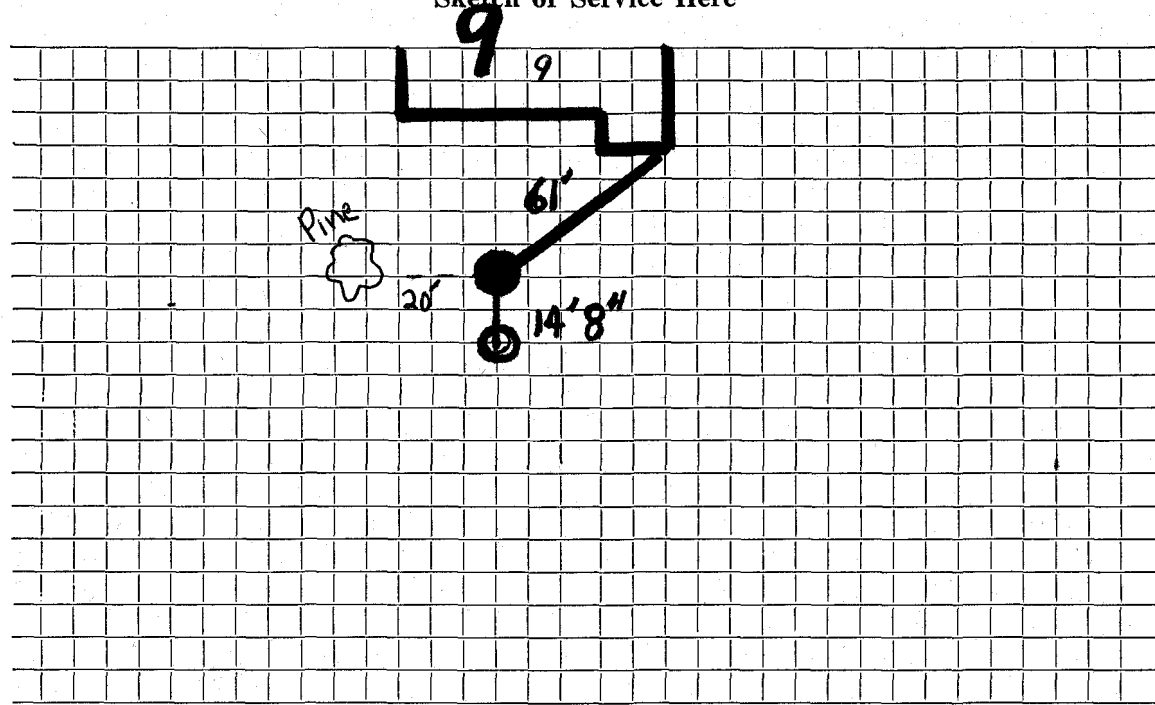

Connection made in Street. Work completed

Remarks:
.....
.....