


TOWN OF LEXINGTON - BOARD OF PUBLIC WORKS  
 WATER DIVISION

Date: 6/3/21

SKETCH OF SERVICE HERE

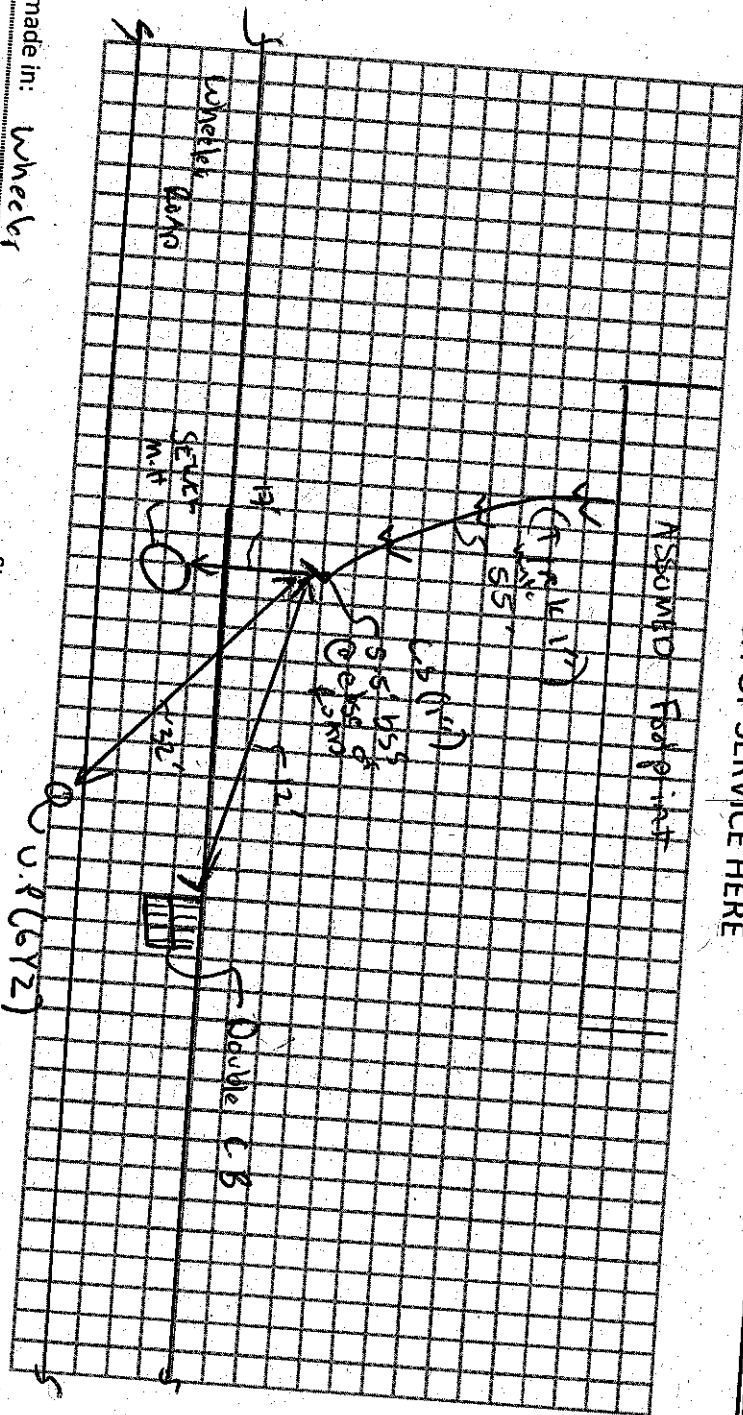

Connection made in: Wheel Well

Street: \_\_\_\_\_

Work completed: \_\_\_\_\_

Remarks:

- Excavation/Earthing Not Built @ time of install
- Proposed to go under footings.

Address 10 wheels farm

Location

Repair - Renewal - New Service

Date	Material	Amount	Total	Date		A
6/3/21	Pano → Hase	.				
	1" LS & B of box					
	1" Type K Copper pipe	✓ 55'				

WATER SERVICE RECORD

Name DeVries Const. Co., Inc.

Service No. 213

Address 10 Wheeler Road

Location

~~Renewal~~ New Service

*Com 11-29-54*

Date	Material	Amount	Total	Date	Amount
9/29/54	Labor	1 85		8-24-54	Deposited 30 00
	10% overhead	19	2 04	11-29-54	* Refunded (5 71)
	50' - 3/4" copper tubing@ .35		17 50		<u>NON CHARGE</u> 24 29
	1 - 3/4" C x 1/2 I.W.H. stop & waste		4 00	9/29/54	Labor 1 12
	1 hr. trucking		75		13' - 3/4" copper tubing@ .35 4 55
			24 29		1 - 3/4" C. corp-cock 4 33
	TRENCH DUG BY OWNER:				1 - 3/4" C. curb-cock 4 67
					1 box and rod 3 90
					1 - 1/2 straight tail piece 50
					1 - 1/2 offset tail piece 50
					1 hr. trucking 75
					<u>20 32</u>


*\* Refund made payable to town to apply on m.b.c # 223*

DATE \_\_\_\_\_

TOWN OF LEXINGTON — BOARD OF PUBLIC WORKS

WATER DIVISION

Sketch of Service Here

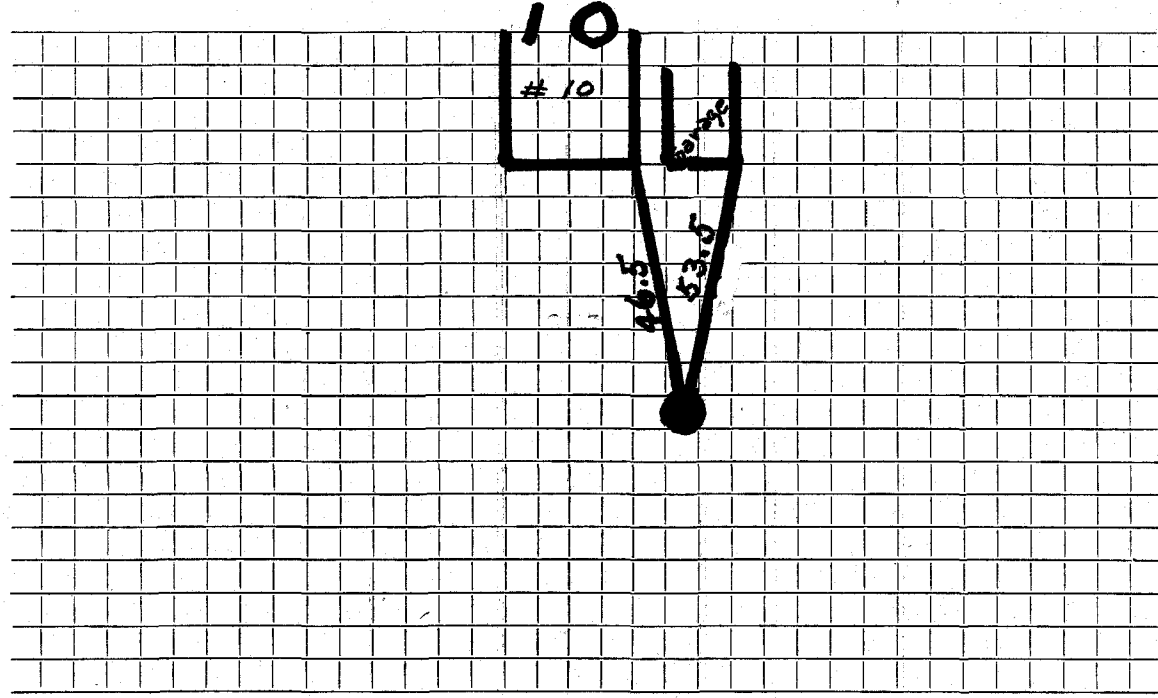

Connection made in ..... Street. Work completed .....

Remarks: .....  
.....  
.....