

WATER SERVICE RECORD

Name DeVries Const. Co., Inc.

Service No. 214

Address 11 Wheeler Road

Location

~~REPAIR REQUEST~~ - New Service

*Conn 11-29-54*


Date	Material	Amount	Total	Date	Amount
9/29/54	Labor	1 85		8-24-54	Deposited 30.00
	10% overhead	19	2 04	11-29-54	Paid (126)
	65' - 3/4" copper tubing @ .35	.35	22 75		<u>NON CHARGE</u> 31 26
	1 - 3/4" C x 1/2 I.W.H. stop & waste		4 00	9/29/54	Labor 1 12
	1 - 3/4" C. union		1 72		19' - 3/4" copper tubing @ .35 6 65
	1 hr. trucking		75		1 - 3/4" C. corp-cock 4 33
			31 26		1 - 3/4" C. curb-cock 4 67
	TRENCH DUG BY OWNER:				1 - box and rod 3 90
					1 - 1/2 straight tail piece 50
					1 - 1/2 offset tail piece 50
					1 hr. trucking 75
					<u>22 42</u>

DATE \_\_\_\_\_

TOWN OF LEXINGTON — BOARD OF PUBLIC WORKS

WATER DIVISION

Sketch of Service Here

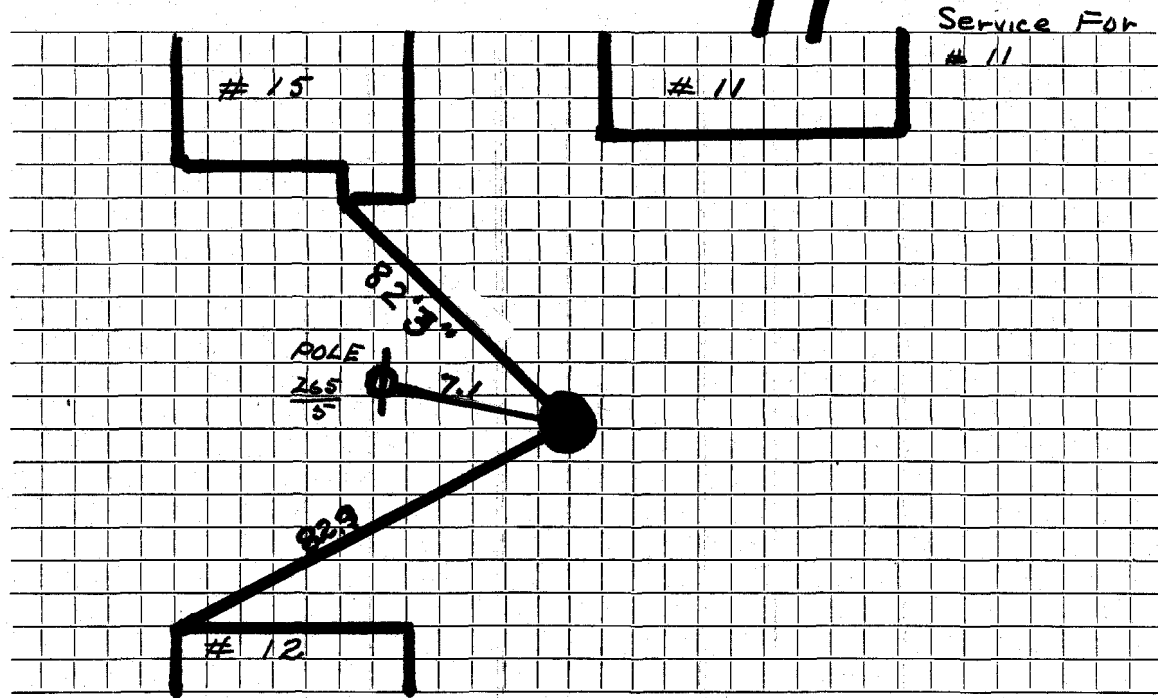

Connection made in ..... Street. Work completed .....

Remarks: .....  
.....  
.....