

WATER SERVICE RECORD

Name DeVries Const. Co., Inc.

Service No. 215

Address 12 Wheeler Road

#7160

Location

~~Repair~~ ~~Renewal~~ — New Service

Cons 11-29-54


Date	Material	Amount	Total	Date	Amount
9/29/54	Labor	1 85		8-24-54	Deposited 90 00
	10% overhead	19	2 04	11-29-54	Refunded (3 99)
	50' - 3/4" copper tubing @ .35	.35	17 50		<u>NON CHARGE</u> 26 01
	1 - 3/4" C x 1/2 I.W.H. stop & waste	4 00	4 00	9/29/54	Labor 1 12
	1 - 3/4" C. union	1 72	1 72	13' - 3/4" copper tubing @ .35	4 55
	1 hr. trucking		75	1 - 3/4" C. corp-cock	4 33
			<u>26 01</u>	1 - 3/4" C. curb-cock	4 67
	TRENCH DUG BY OWNER:			1 box and rod	3 90
				1 - 1/2 straight tail pc.	50
				1 - 1/2 offset tail piece	50
				1 hr. trucking	75
					<u>20 32</u>

DATE _____

TOWN OF LEXINGTON — BOARD OF PUBLIC WORKS

WATER DIVISION

Sketch of Service Here

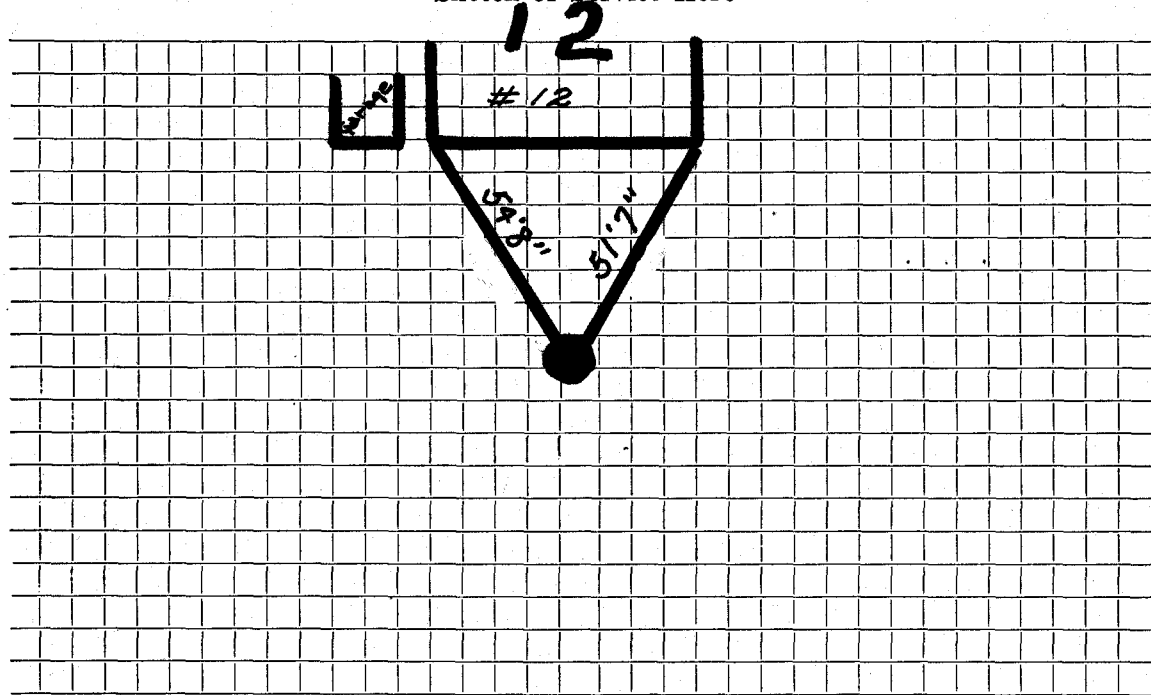

Connection made in Street. Work completed

Remarks:
.....
.....