


TOWN OF LEXINGTON — BOARD OF PUBLIC WORKS

WATER DIVISION

16

Sketch of Service Here

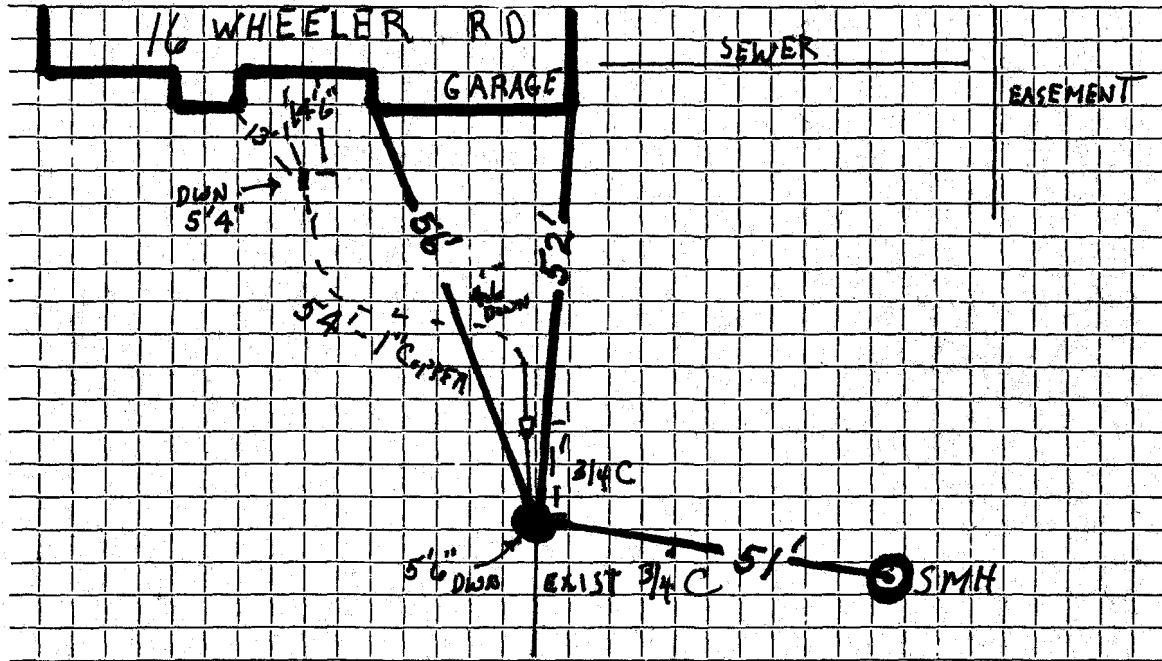

Connection made in WHEELER RD 7/1/96..... Street. Work completed

Remarks: 1' FROM CURB INCREASED TO 1" COPPER

PERMIT NO. 0827