

WATER SERVICE RECORD

3006

Name DeVries Const. Co., Inc.

Service No. 218

Address 17 Wheeler Road

Location

~~Repair/Replacement~~ New Service

Com 11-29-54


Date	Material	Amount	Total	Date	Amount
9/29/54	Labor	1 85		8-24-54	Deposited 20 00
	10% overhead	19	2 04	11-29-54	Refunded (4 66)
	53' - 3/4" copper tubing@ .35	.35	18 55		<u>NON CHARGE</u> 25 34
	1 - 3/4"C x 1/2 I.W.H. stop & waste	4 00	4 00	9/29/54	Labor 1 12
	1 hr. trucking		75	19' - 3/4" copper tubing@ .35	6 65
			25 34	1 - 3/4"C. corp-cock	4 33
	TRENCH DUG BY OWNER:			1 - 3/4"C curb-cock	4 67
				1 box and rod	3 90
				1 - 1/2 straight tail pc.	50
				1 - 1/2 offset tail pc.	50
				1 hr. trucking	75
					<u>22 42</u>

DATE _____

TOWN OF LEXINGTON — BOARD OF PUBLIC WORKS

WATER DIVISION

Sketch of Service Here

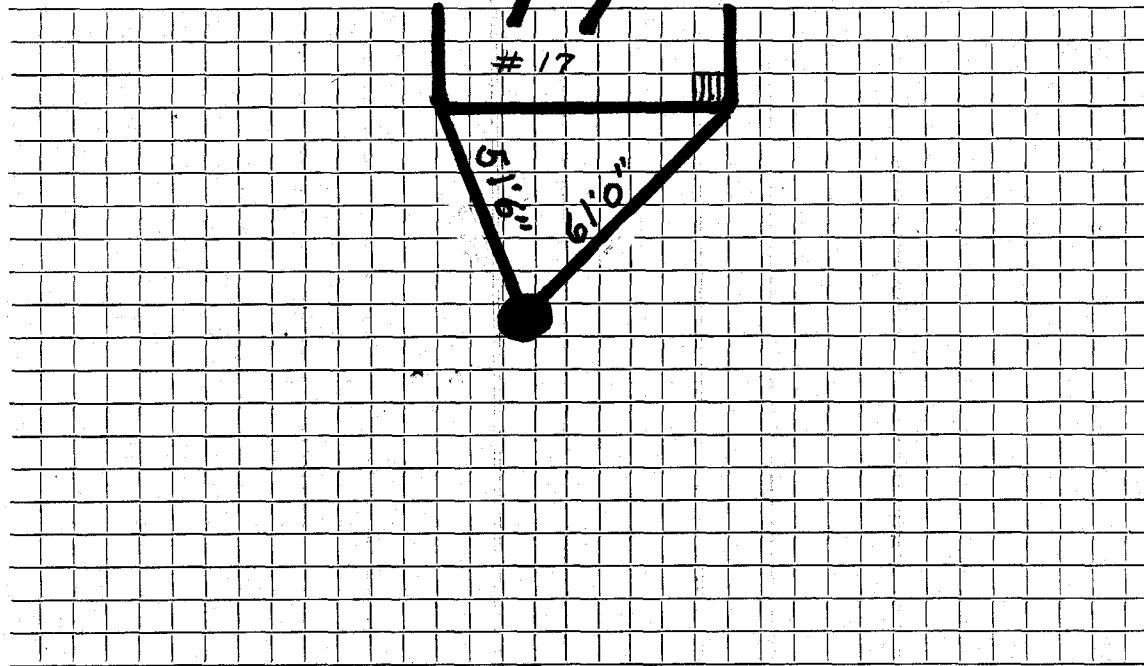

Connection made in Street. Work completed

Remarks:
.....
.....