

WATER SERVICE RECORD

Name DeVries Const. Co., Inc.

Service No. 219

Address 18 Wheeler Road

Location

~~RENEWAL~~ ~~RENEWAL~~ New Service

*Com. 11-29-54*


Date	Material	Amount	Total	Date	Amount
9/29/54	Labor	1 85		<i>9-29-54</i>	
	10% overhead	19	2 04	<i>11-29-54</i>	
	64' - 3/4" copper tubing @ .35		22 40	<i>Deposited</i>	
	1 - 3/4" C x 1/2" I.W.H. stop & waste		4 00	<i>54</i>	
	1 - 3/4" C. union		1 72		
	1 hr. trucking		75		
			30 91		
	TRENCH DUG BY OWNER:				
				9/29/54	Labor
					1 12
				13' - 3/4" copper tubing @ .35	4 55
				1 - 3/4" C. corp-cock	4 33
				1 - 3/4" C. curb-cock	4 67
				1 box and rod	3 90
				1 - 1/2" offset tail piece	50
				1 - 1/2" straight tail piece	50
				1 hr. trucking	75
					20 32

DATE \_\_\_\_\_

TOWN OF LEXINGTON — BOARD OF PUBLIC WORKS

WATER DIVISION

Sketch of Service Here

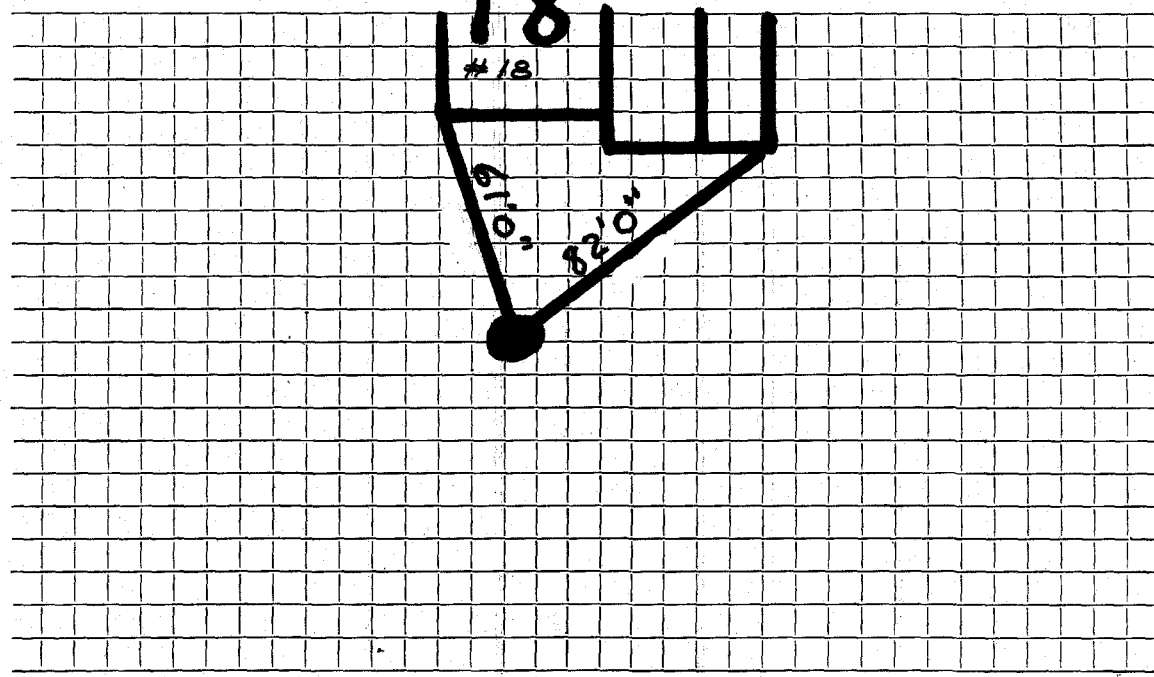

Connection made in ..... Street. Work completed .....

Remarks: .....  
.....  
.....