

WATER SERVICE RECORD

Name DeVries Const. Co., Inc.

Service No. 205

Address 2 Wheeler Road

Location

~~Repair~~ ~~Renew~~ - New Service

Com 11-29-54

Date	Material	Amount	Total	Date	Amount
9/28/54	Labor	1 85		8-24-54	30 00
	10% overhead	19	2 04	11-29-54	(2 91)
	58' - 3/4" copper tubing@	.35	20 30		<u>NON CHARGE</u>
	1 - 3/4"C x 1/2 I.W.H. Stop & waste	4 00	9/28/54	Labor	1 12
	1 hr. trucking		75	13' - 3/4" copper tubing@	4 55
			27 09	1 - 3/4"C. corp-coek	4 33
	TRENCH DUG BY OWNER:			1 - 3/4"C. curb-coek	4 67
				1 box and rod	3 90
				1 - 1/2 straight tail piece	50
				1 - 1/2 offset tail piece	50
				1 hr. trucking	75
					<u>20 32</u>


** Refund made payable to town
to apply on m.h.c # 211 & # 223*

DATE _____

TOWN OF LEXINGTON — BOARD OF PUBLIC WORKS

WATER DIVISION

Sketch of Service Here

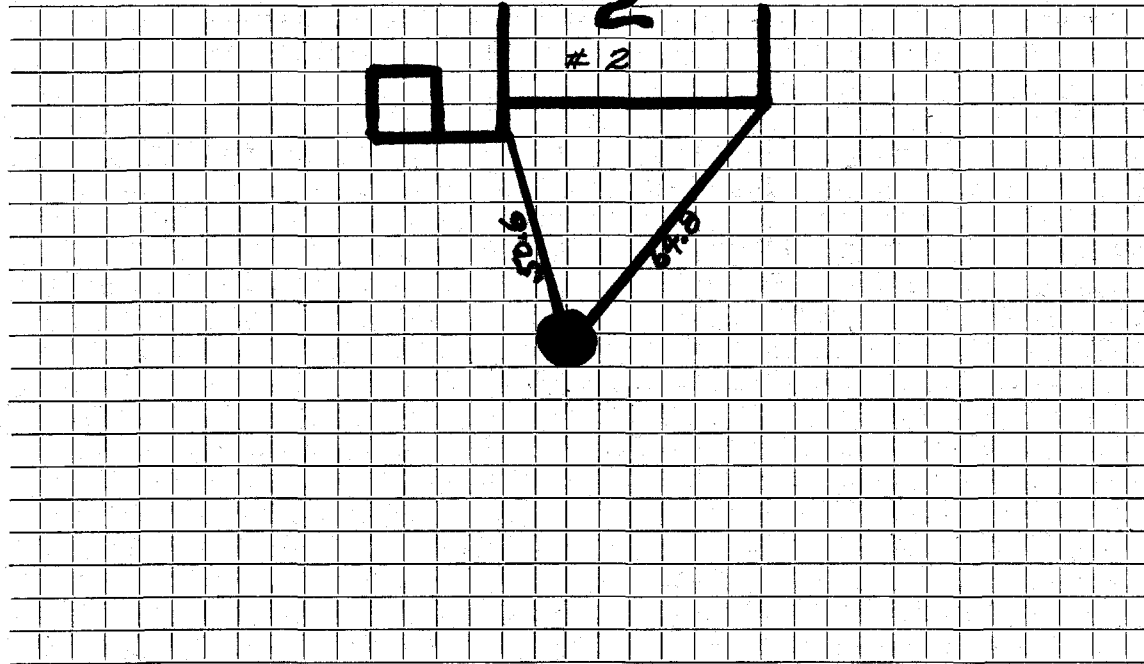

Connection made in Street. Work completed

Remarks:

.....

.....