

WATER SERVICE RECORD

5742
8796

Name DeVries Const. Co., Inc.

Service No. 221

Address 20 Wheeler Road

Location

~~REPAIR SERVICE~~ - New Service

Am 11-29-54


Date	Material	Amount	Total	Date	Amount
9/29/54	Labor	1 85		8-24-54	Deposited 20 00
	10% overhead	19	2 04	11-29-54	Paid (4 06)
	73' - 3/4" copper tubing @ .35	.35	25 55		<u>NON CHARGE</u> 24 06
	1 - 3/4"C x 1/2 I.W.H. stop & waste	4 00		9/29/54	Labor 1 12
	1 - 3/4"C. union		1 72		13' - 3/4" copper tubing @ .35 4 55
	1 hr. trucking		75		1 - 3/4"C. corp-cock 4 33
			34 06		1 - 3/4"C. curb-cock 4 67
	TRENCH DUG BY OWNER:				1 - box and rod 3 90
					1 - 1/2 straight tail piece 50
					1 - 1/2 offset tail piece 50
					1 hr. trucking 75
					<u>20 32</u>
					NON-CHARGE
					Repair broken service
				12-18-74	3 hrs. Labor
					3' 3/4" copper tubing
					2 3/4" 3 part unions

DATE _____

TOWN OF LEXINGTON — BOARD OF PUBLIC WORKS

WATER DIVISION

Sketch of Service Here

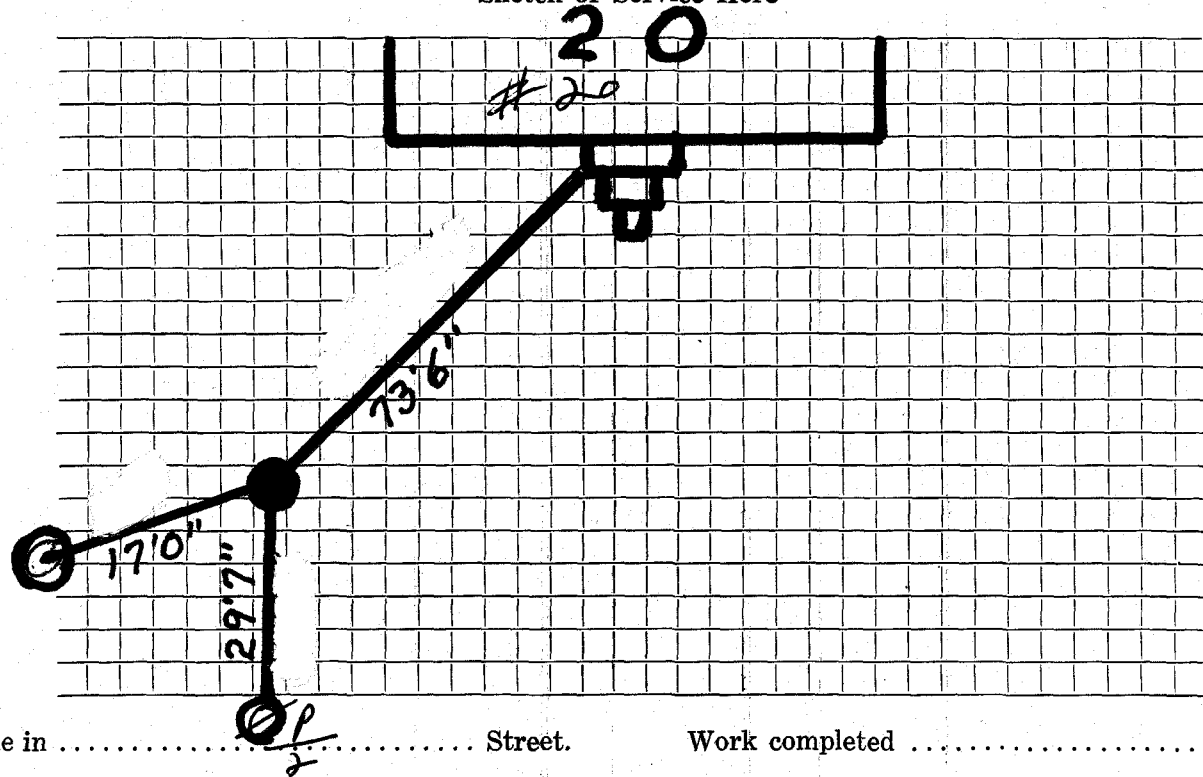

Connection made in Street. Work completed

Remarks:
.....
.....