Service No.

Name		

Wheeler Rd Address


Location

Repair Renewal New Service									
Date	Material	Amount	Total	Date		Amount			
5/11/2021	1"type k capper								
						· — ·			
	1" curb stop open right camb brass								
	open right	<del></del>	<u> </u>						
. <u>Propried State</u>	camb, brass								
	4 66 0	<u> </u>							
Alba Alba Ma	Buffalo Box								
		·			<u> </u>	·			
	***************************************	<u> </u>		· · · · · · · · · · · · · · · · · · ·		. <u> </u>			
					·				

Date: 5/11/21

## TOWN OF LEXINGTON - BOARD OF PUBLIC WORKS WATER DIVISON

## SKETCH OF SERVICE HERE

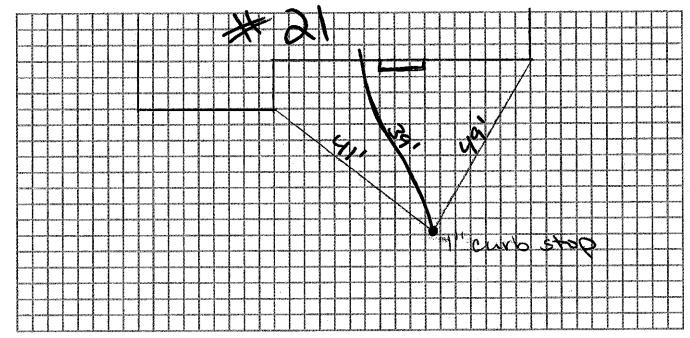

Connection made in: Work completed:

Remarks: